NOTE :
THE PHASED IMPLEMENTATION PLAN (WITH PHASE 1 DELIVERED ON [---], PHASE 2 ON [---], PHASE 3 ON [---], AND PHASE 4 ON [---]) IS FULLY ALIGNED WITH TIKTOK'S DEVICE INSTALLATION SCHEDULE. THE OVERALL PROJECT TIMELINE AND FINAL DELIVERY DATE REMAIN UNCHANGED, AND ALL WORK MUST BE COMPLETED WITHIN THE INTEGRATED SCOPE OF THE ENTIRE PROJECT.

LEED NOTE:
1、ALL ADHESIVES, SEALANTS, PAINTS, PRIMERS, AND COATINGS SHALL BE LOW-VOC CONTENT AND LOW-VOC EMISSIONS MATERIALS.
2、ALL CEILING BOARDS SHALL BE LOW-VOC EMISSIONS MATERIALS.
3、USED AT LEAST 20 EPD PRODUCTS FROM 5 MANUFACTURERS.
4、ALL MATERIALS SHALL COMPLY WITH LEED TOR."

☐	PHASE 1(------)	☐	PHASE 3(------)
☐	PHASE 2(----)	☐	PHASE 4(------)

Modified according to the review comments (ACM_GSA03_DesignReview_SD60_Rev B - Arch)

Modified according to the review comments (ACM_GSA03_DesignReview_SD60_Rev B - Arch)

Modified according to the review comments (ACM_GSA03_DesignReview_SD60_Rev B - Arch)

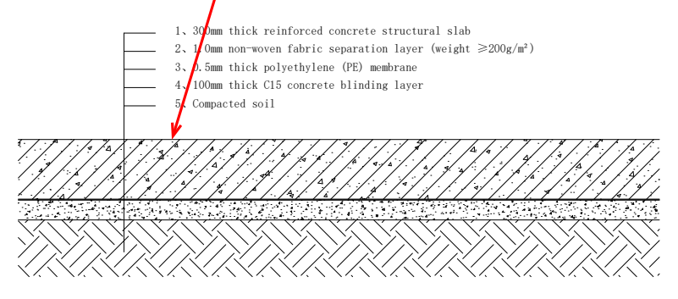
1、300mm thick reinforced concrete structural slab
2、1.0mm non-woven fabric separation layer (weight ≥200g/m²)
3、0.5mm thick polyethylene (PE) membrane
4、100mm thick C15 concrete blinding layer
5、Compacted soil

Typical Detail-Ground Floor Damp-Proof Course

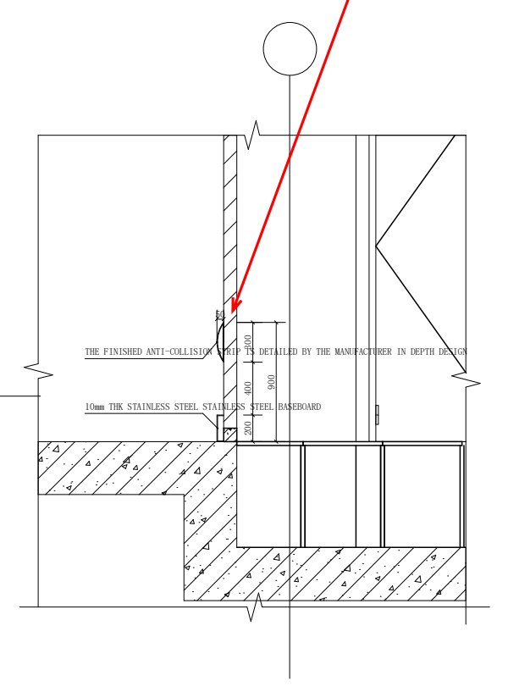
THE FINISHED ANTI-COLLISION STRIP IS DETAILED BY THE MANUFACTURER IN DEPTH DESIGN
10mm THK STAINLESS STEEL STAINLESS STEEL BASEBOARD
200
400
900

Collision strip Detailed Drawings

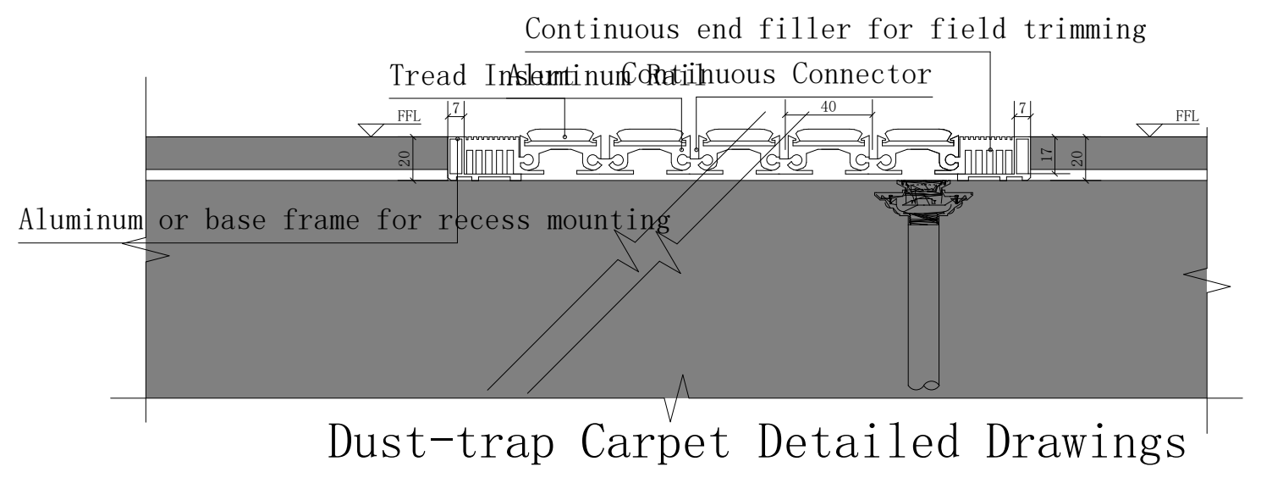
Continuous end filler for field trimming
Tread Insert
Aluminum Rail
Continuous Connector
Aluminum or base frame for recess mounting
FFL
7
20
40
17

Dust-trap Carpet Detailed Drawings

1ST FLOOR PHASING PLAN (DC BUILDING A) PART 1

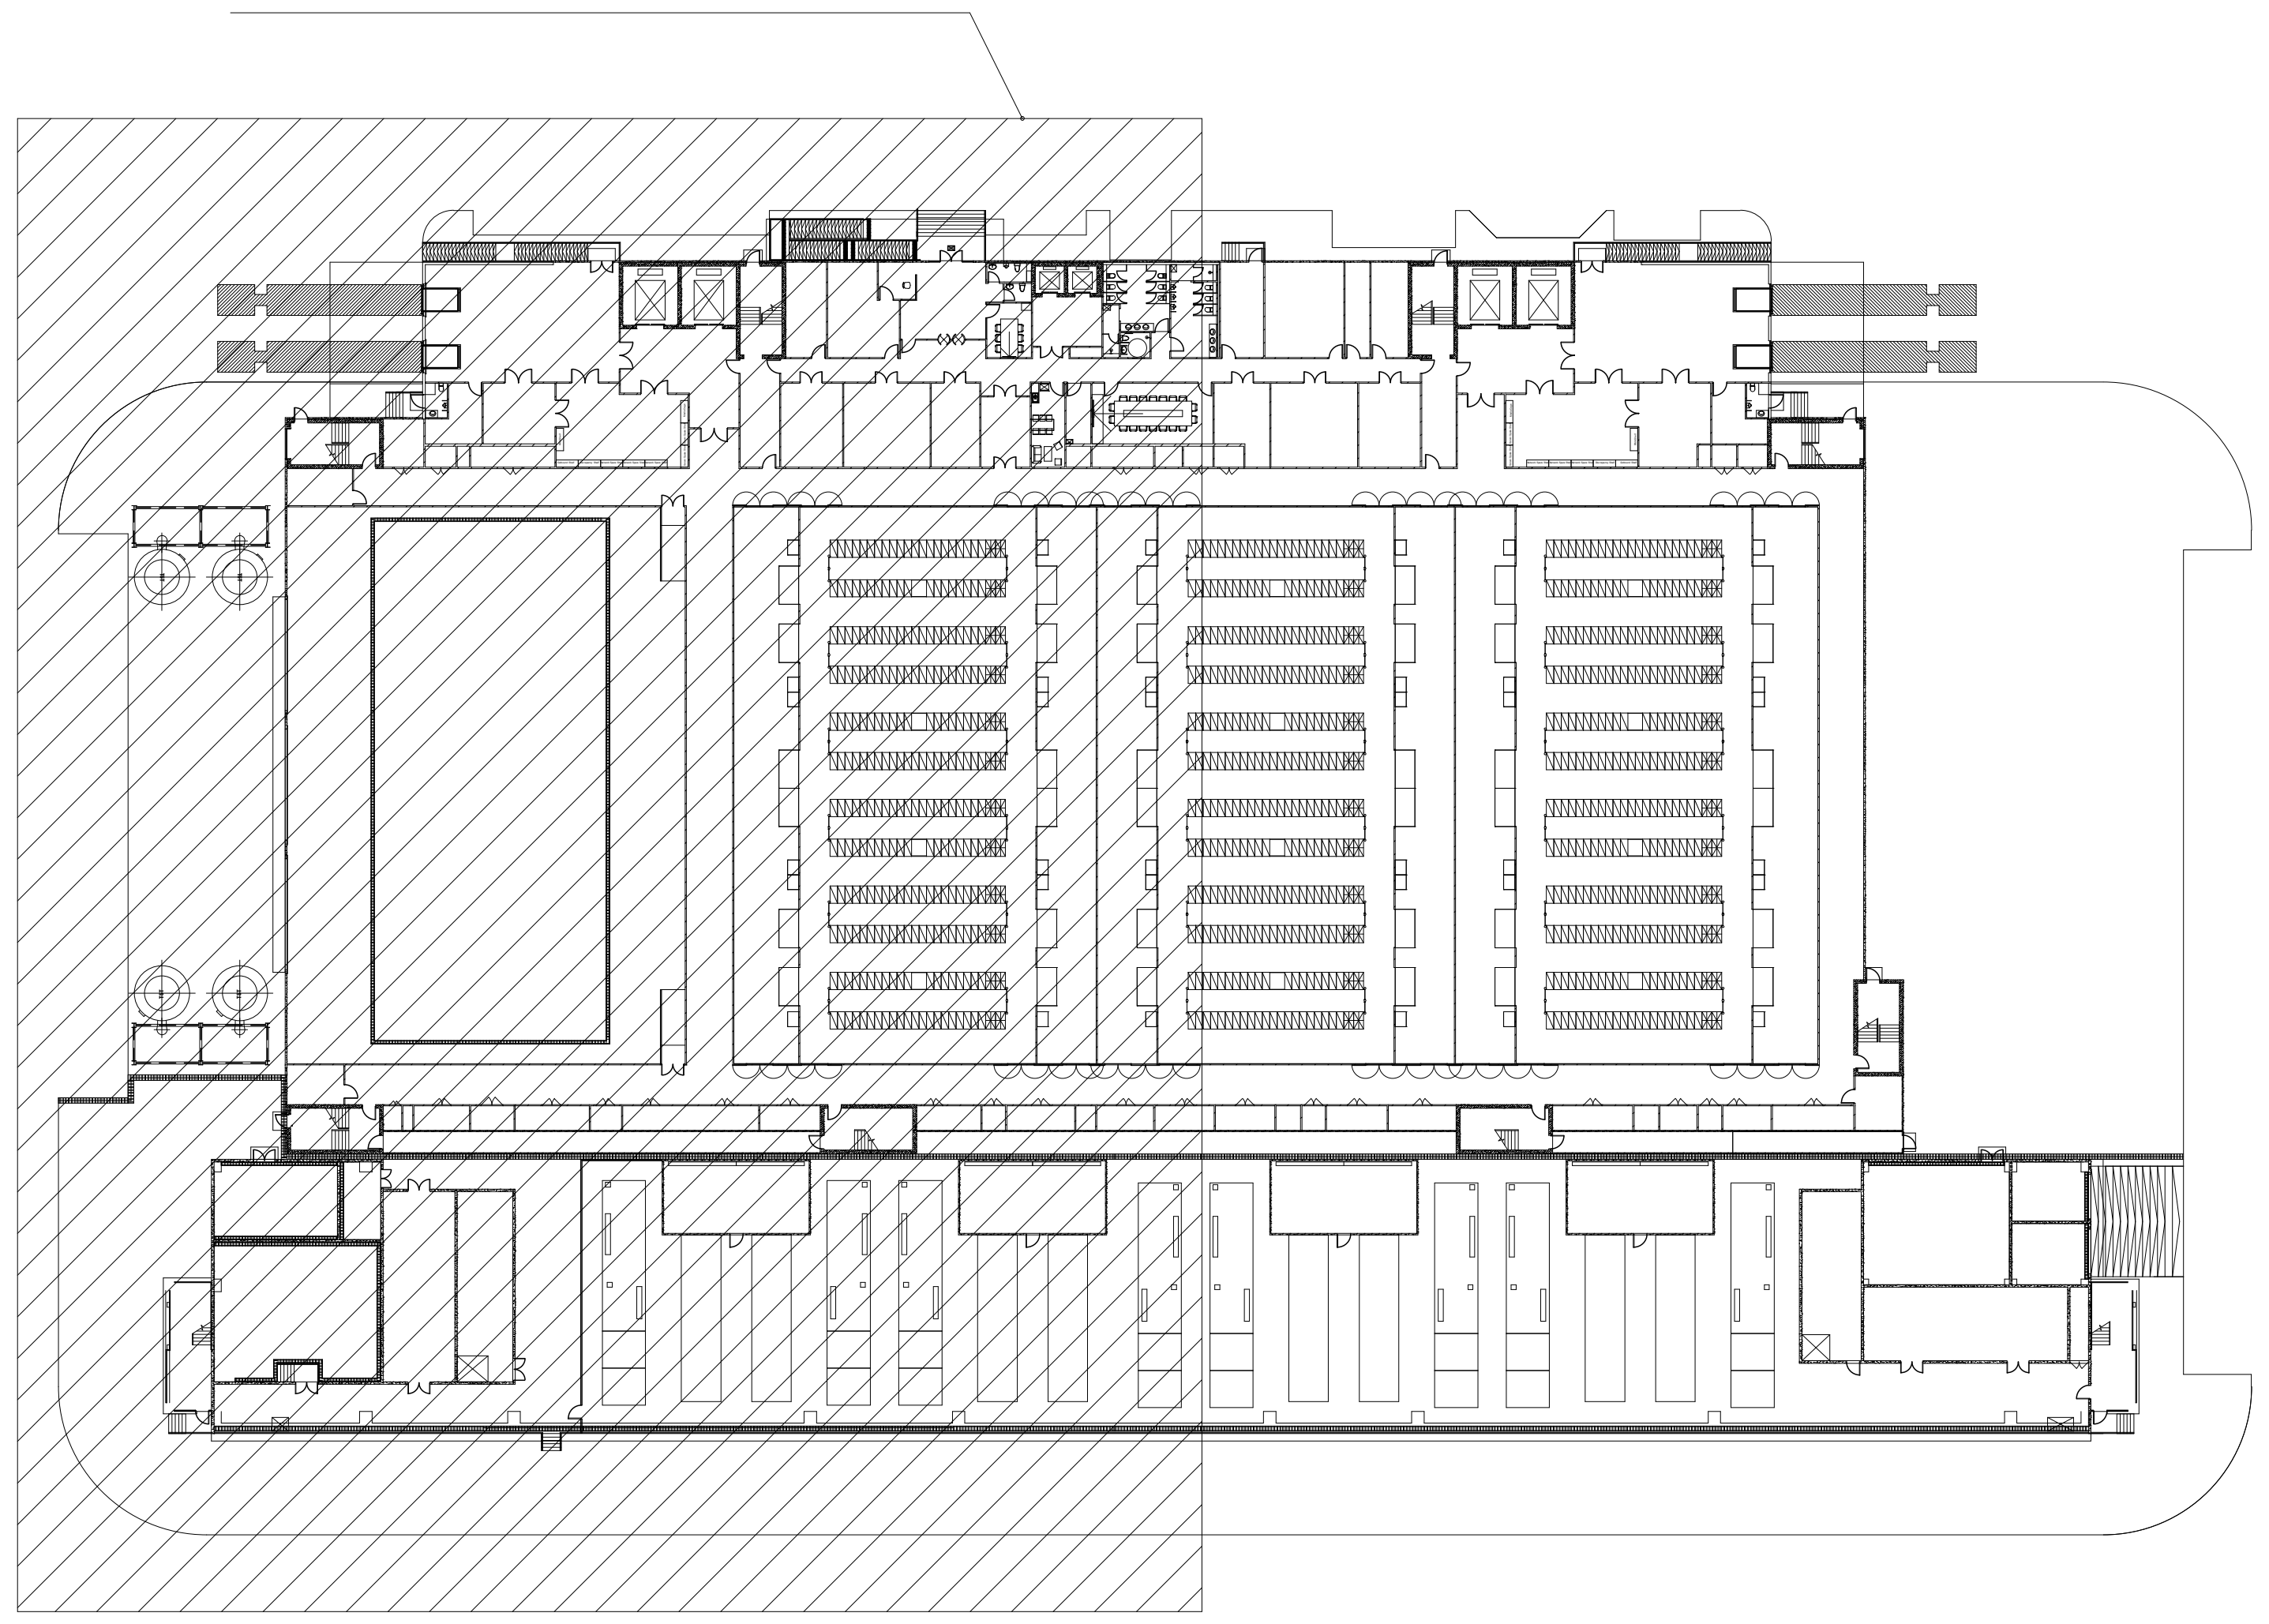

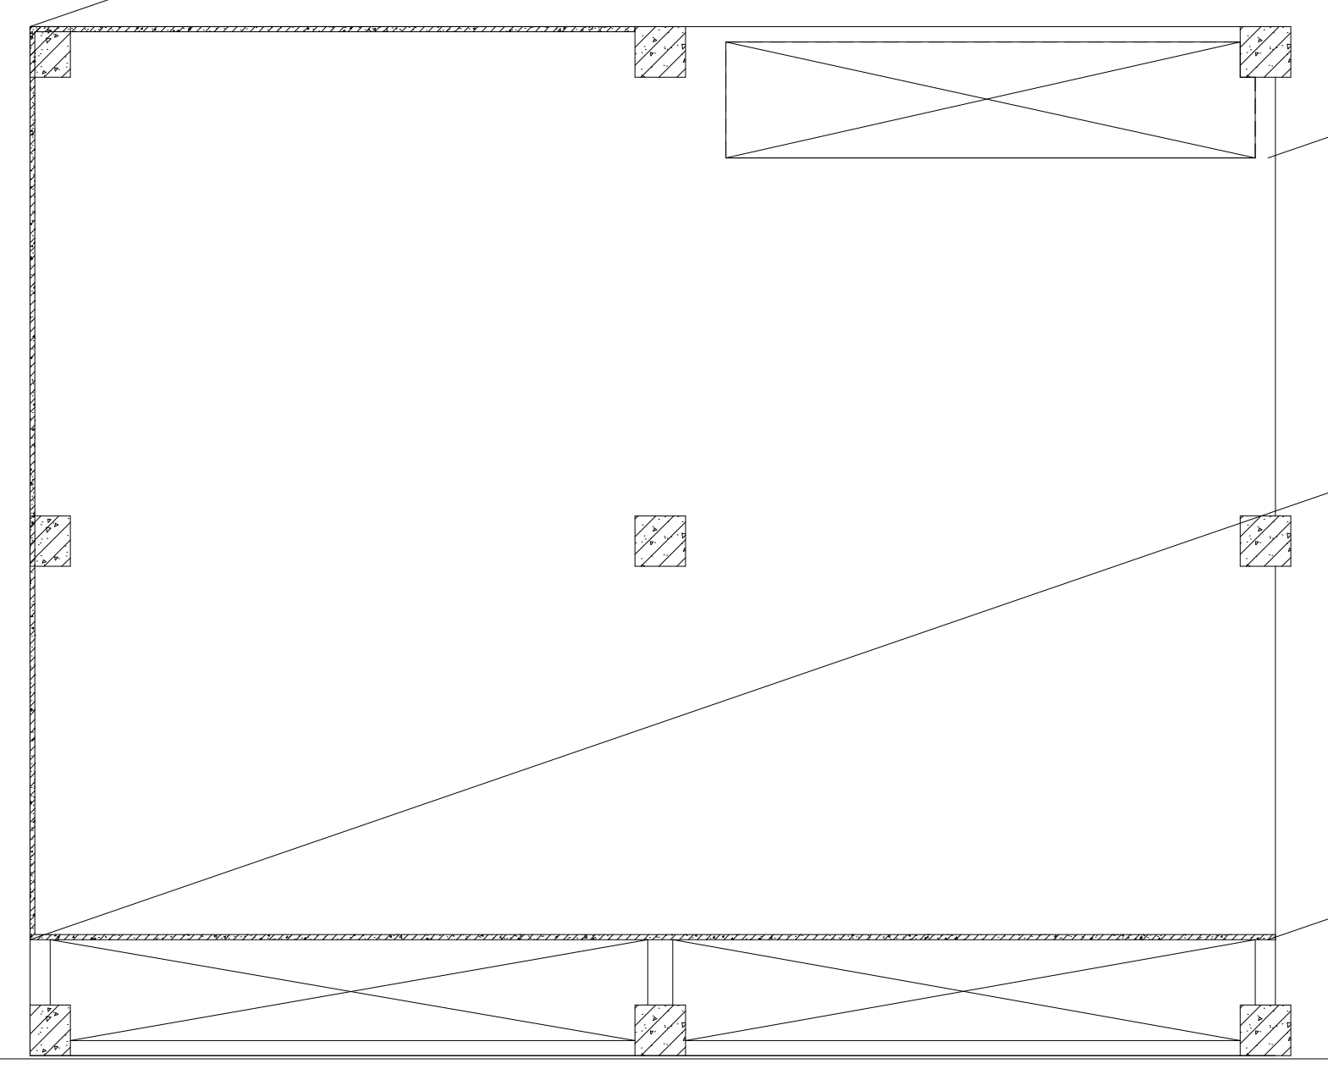

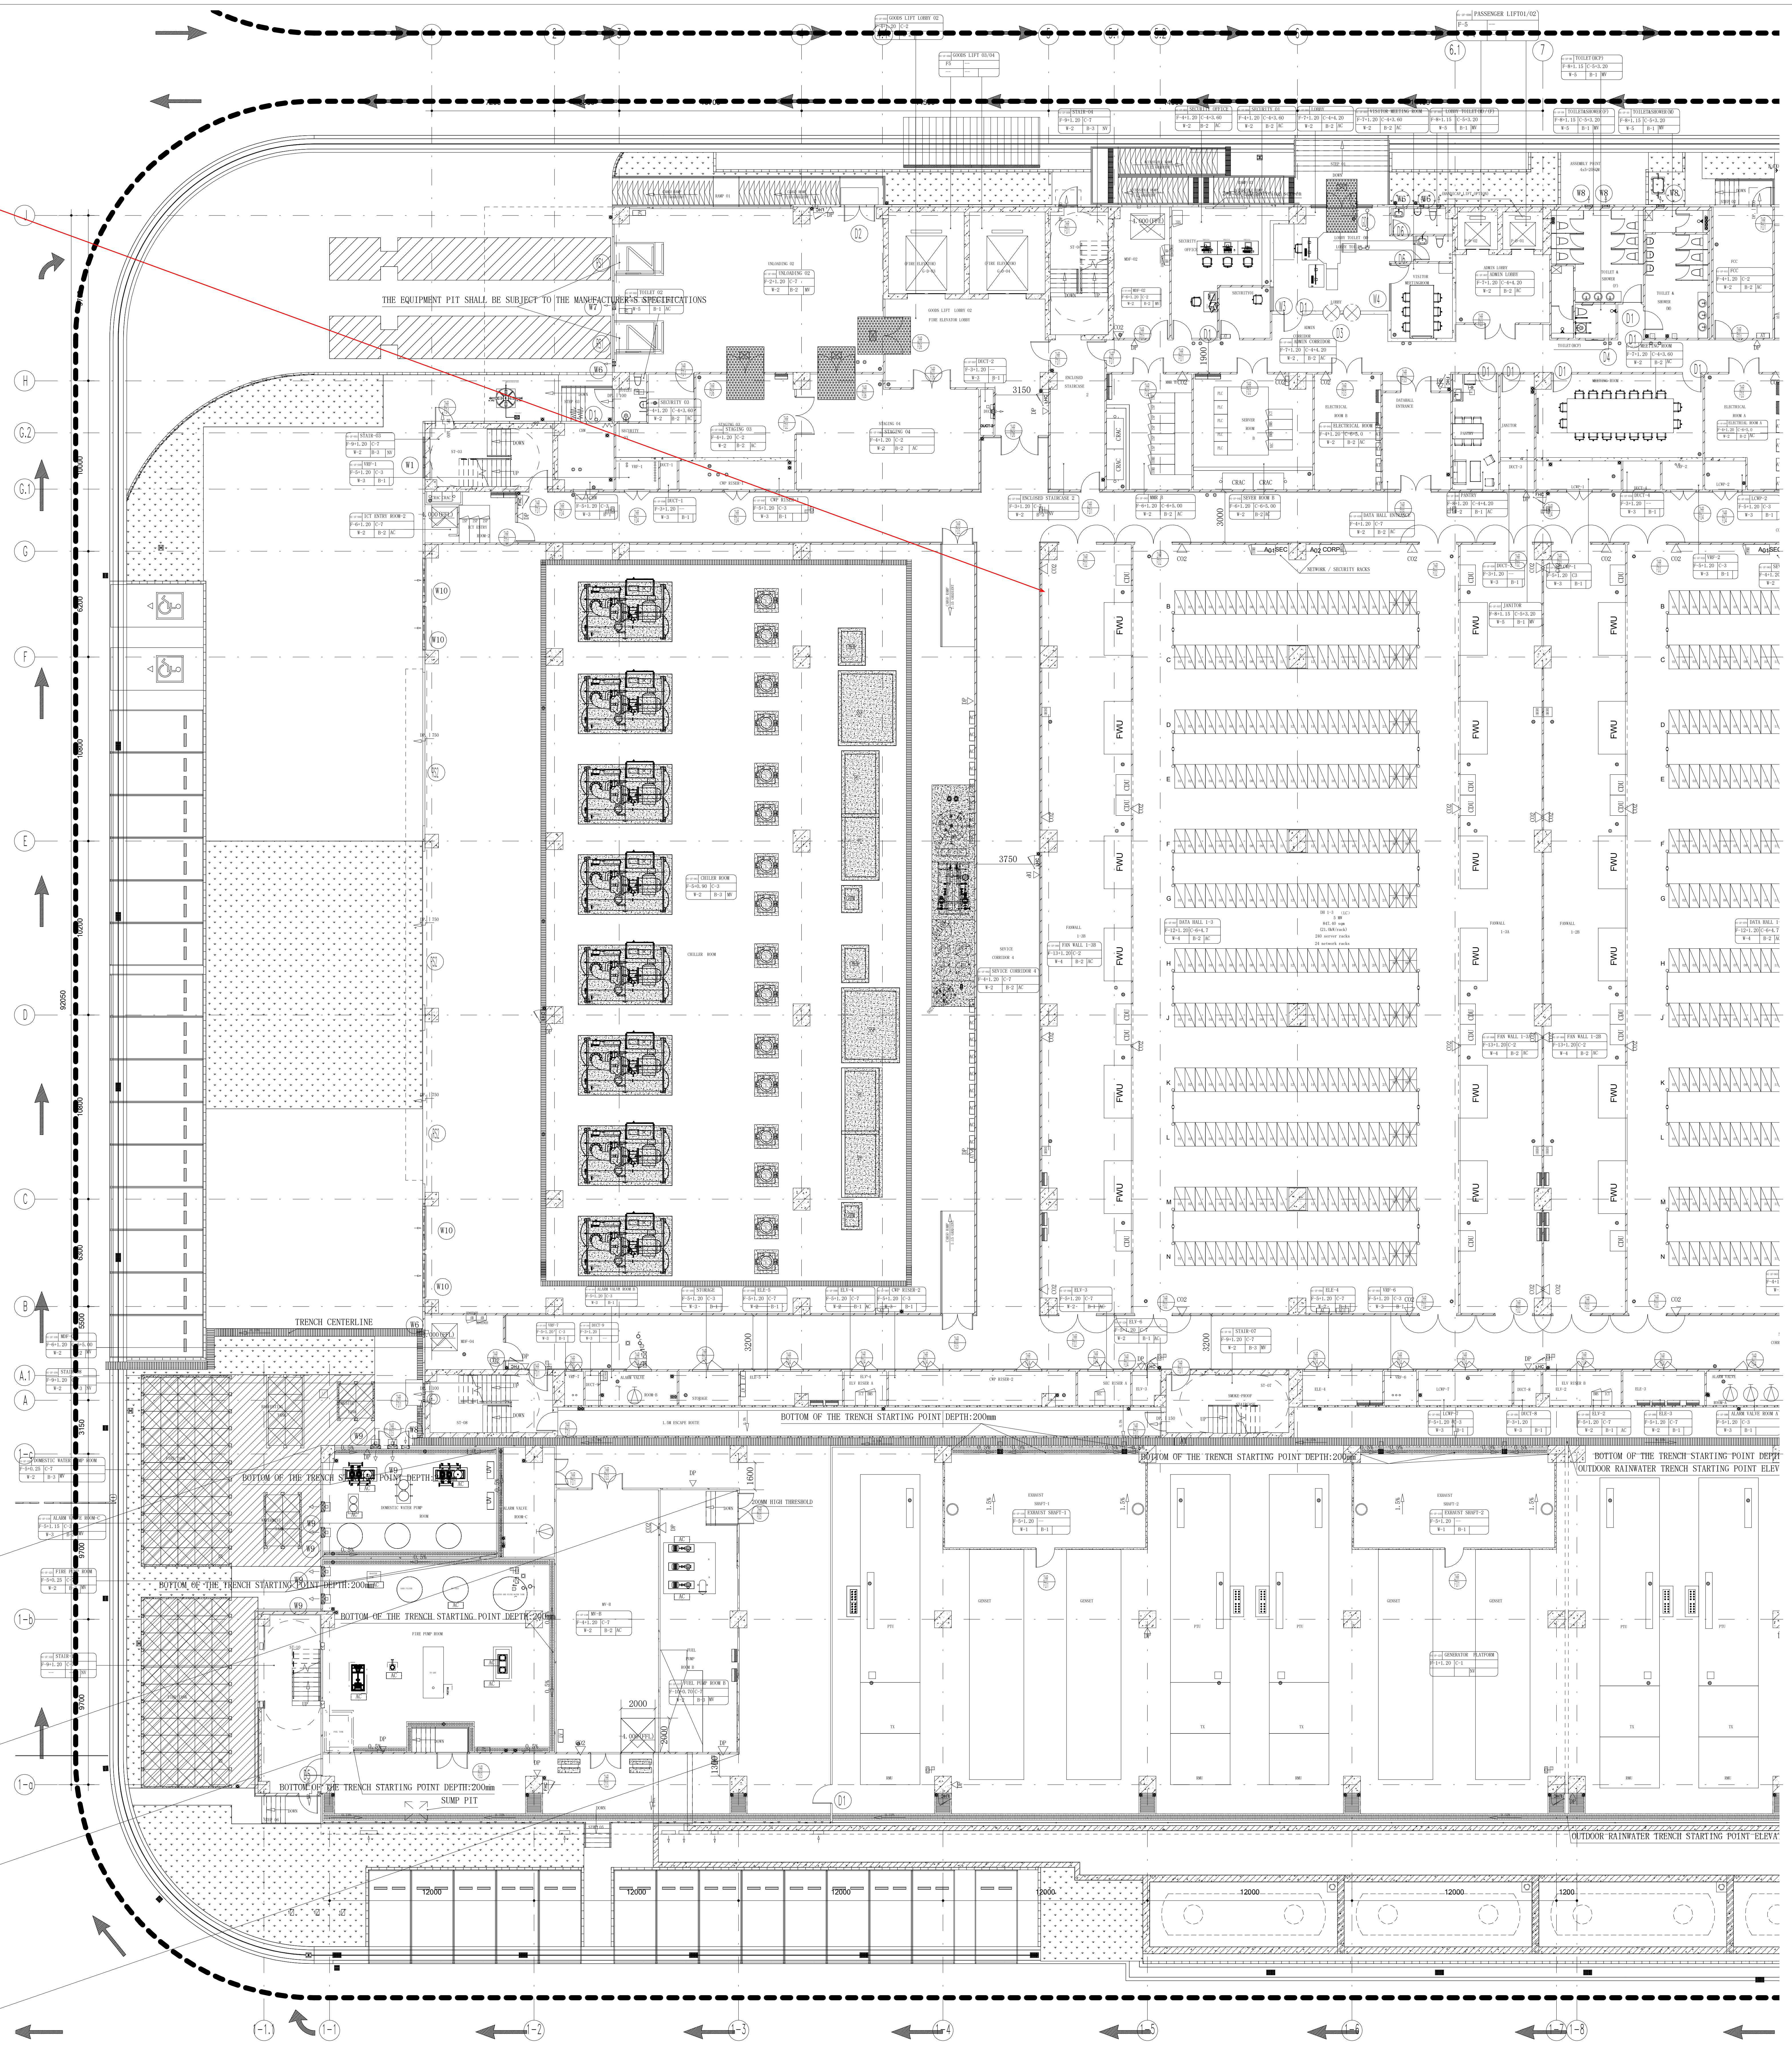
THE EQUIPMENT PIT SHALL BE SUBJECT TO THE MANUFACTURER'S SPECIFICATIONS
TRENCH CENTERLINE
BOTTOM OF THE TRENCH STARTING POINT DEPTH:200mm
SUMP PIT
OUTDOOR RAINWATER TRENCH STARTING POINT ELEVA
FWU
3150
3750
3200
2000
92050
12000
G.1
G
F
E
D
C
B
A.1
A
H

1ST FLOOR PHASING PLAN(DC BUILDING A)PART 1

NOTE :THIS PRINT IS OF A CONFIDENTIAL NATURE, IT SHALL NOT BE TRACED,PHOTOGRAPHED,PHOTOSTATED OR REPRODUCED IN ANY MANER,NOR USED FOR ANY PURPOSE WHATSOEVER EXCEPT BY WRITTEN PERMISSION

CLIENT :

GULF EDGE DC 01

87 Wireless Road, M Thai Tower 11th. Floor, All Seasons Place, Lumpini, Pathumwan, Bangkok 10330, Thailand

CONTRACTOR :

华西发展(泰国)有限公司
บริษัท หัวซือ ดีเวลลอปเม้นต์ (ประเทศไทย) จำกัด
HUASHI DEVELOPMENT CO.,LTD
No. 202, Room No. 1403, 14/F, Le Concorde Building,
Ratchadapisek Road, Huaykhwang Sub-District,
Huaykhwang District, Bangkok Metropolitan 10310.

CONSULTANT :

ARbay
บริษัท เอ อาร์ เบย์ จำกัด
ARbay Company Limited
31 st Floor Bangkok Insurance Building
25 South Sathorn road Thungmahamek
Sathorn Bangkok 10120 THAILAND
T +66 (0) 2286 8199
F +66 (0) 2286 2863
info@arbay.co.th

CONSULTANT :

Qbic Engineers & Architects Co.,Ltd.
8 Soi KALONG 4 SANAMBINNAM ROAD,
THASAI SUB-DISTRICT, MUANG NONTHABURI DISTRICT
, NONTHABURI.
Tel 662-950-4374
Fax 662-580-3231
E-Mail : qbic@qbic.co.th, www.qbic.co.th
QBIC ENGINEERS AND ARCHITECTS CO.,LTD.

CONSULTANT :

MITR
MITR TECHNICAL CONSULTANT CO.,LTD.
1168/8 12th FLOOR, LUMPINI TOWER BUILDING,
RAMA IV RD., THUNGMAHAMEK, SATHORN, BANGKOK 10120, THAILAND
TEL : 0-2679-9079-84
FAX : 0-2679-9085 E-mail: mitr_dd@mitr.com

Architect :	SIGNATURE
ประกิต พนานุรัตน์ วสถ. 580 ที่อยู่ 251/1 ถ.จารุเมือง แขวงรองเมือง เขตปทุมวัน กรุงเทพมหานคร โทรศัพท์ 02-286-8199	
Structural Engineer :	SIGNATURE
วิศวกรผู้ออกแบบโครงสร้าง	
ณัฐสม สงวนวงษ์ วย 1423 ที่อยู่ 2/1 ซ.รามคำแหง 150 ถ.รามคำแหง แขวง สะพานสูง เขต สะพานสูง กทม. 10240	ณัฐสม สงวนวงษ์
Structural Inspector :	SIGNATURE
วิศวกรผู้ตรวจสอบโครงสร้าง	
โกมล จุฑาภัทร วย 964 ที่อยู่ 24/18 ซ.นวมินทร์ 129 ถ. นวมินทร์ แขวง นวลจันทร์ เขต บึงกุ่ม กทม. 10230	
Electrical Engineer :	SIGNATURE
วิศวกรผู้ออกแบบระบบไฟฟ้ากำลัง	
นายสุภัทร บูรณวิทย์ วฟก.1265 ที่อยู่ 21 ซอยทานสัมฤทธิ์ 13 ตำบลท่าทราย อ.เมืองนนทบุรี จ.นนทบุรี 11000	สุภัทร บูรณวิทย์
Mechanical Engineer :	SIGNATURE
วิศวกรผู้ออกแบบระบบเครื่องกลและปรับอากาศ	
นายประสิทธิ์ เกี้ยวสุนทร วก.1221 ที่อยู่ 44/372 ซอยบางกระดี่ 35/1 แขวงแสมดำ เขตบางขุนเทียน กทม. 10150	ประสิทธิ์
Sanitary Engineer :	SIGNATURE
วิศวกรผู้ออกแบบระบบสุขาภิบาล และดับเพลิง	
นายทศวรรษ สนั่นฤทธิ์ วส. 215 ที่อยู่ บ้านเลขที่ 99/107 หมู่ที่ 3 ต.ศีรษะจรเข้น้อย อ.บางเสาธง จ.สมุทรปราการ 10540	ทศวรรษ

ISSUE/REVISION

REV.	DESCRIPTION	DATE
A	90% DEVELOPED	09/05/2026

PROJECT NAME :

GEDC 01

LOCATION:
Nikhom Phattana district, Rayong ,industrial estate,CPGC

BUILDING :
MAIN BUILDING

90% DEVELOPED

TITLE :

1ST FLOOR PHASING PLAN(DC BUILDING A)PART 1

JOB NO.		SCALE	1 : 150
DRAWN	KHJ	REF.	
CHECKED	LJC	DWG. NO.	MPK01A-90-A-P-102
APPROVED	LXD		
DATE	2026.05.09		