NOTE :
THE PHASED IMPLEMENTATION PLAN (WITH PHASE 1 DELIVERED ON [---], PHASE 2 ON [---], PHASE 3 ON [---], AND PHASE 4 ON [---]) IS FULLY ALIGNED WITH TIKTOK'S DEVICE INSTALLATION SCHEDULE. THE OVERALL PROJECT TIMELINE AND FINAL DELIVERY DATE REMAIN UNCHANGED, AND ALL WORK MUST BE COMPLETED WITHIN THE INTEGRATED SCOPE OF THE ENTIRE PROJECT.

LEED NOTE:
1、ALL ADHESIVES, SEALANTS, PAINTS, PRIMERS, AND COATINGS SHALL BE LOW-VOC CONTENT AND LOW-VOC EMISSIONS MATERIALS.
2、ALL CEILING BOARDS SHALL BE LOW-VOC EMISSIONS MATERIALS.
3、USED AT LEAST 20 EPD PRODUCTS FROM 5 MANUFACTURERS.
4、ALL MATERIALS SHALL COMPLY WITH LEED TOR."

☐ PHASE 1(------)
☐ PHASE 2(----)
☐ PHASE 3(------)
☐ PHASE 4(------)

odified according to the review comments (ACM_GSA03_DesignReview_SD60_Rev B - Arch)

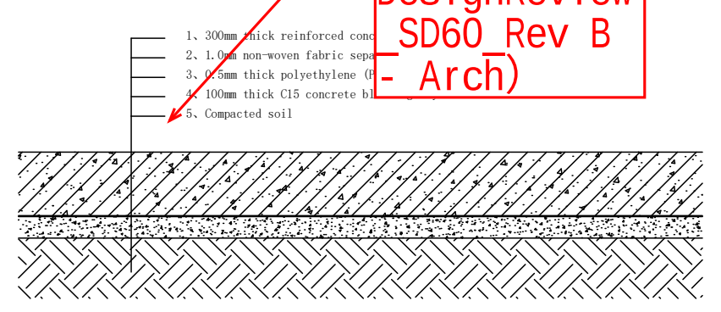
1、300mm thick reinforced conc
2、1.0mm non-woven fabric sepa
3、0.5mm thick polyethylene (P
4、100mm thick C15 concrete bl
5、Compacted soil

Typical Detail-Ground Floor Damp-Proof Course

odified according to the review comments (ACM_GSA03_DesignReview_SD60_Rev B - Arch)

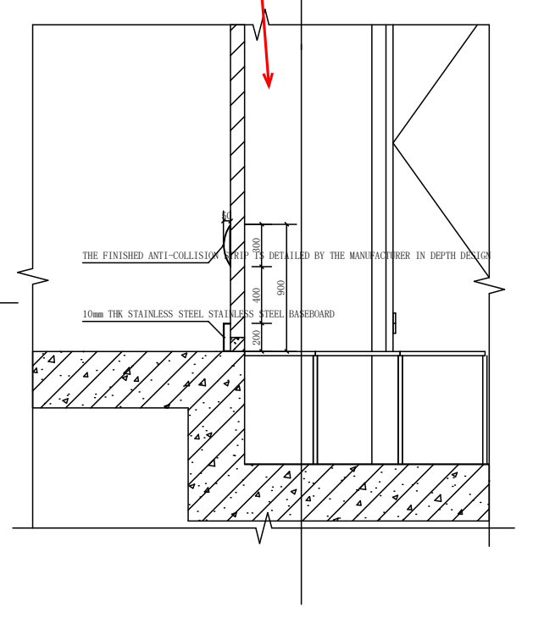
THE FINISHED ANTI-COLLISION STRIP IS DETAILED BY THE MANUFACTURER IN DEPTH DESIGN
10mm THK STAINLESS STEEL STAINLESS STEEL BASEBOARD
1200
400
900
200

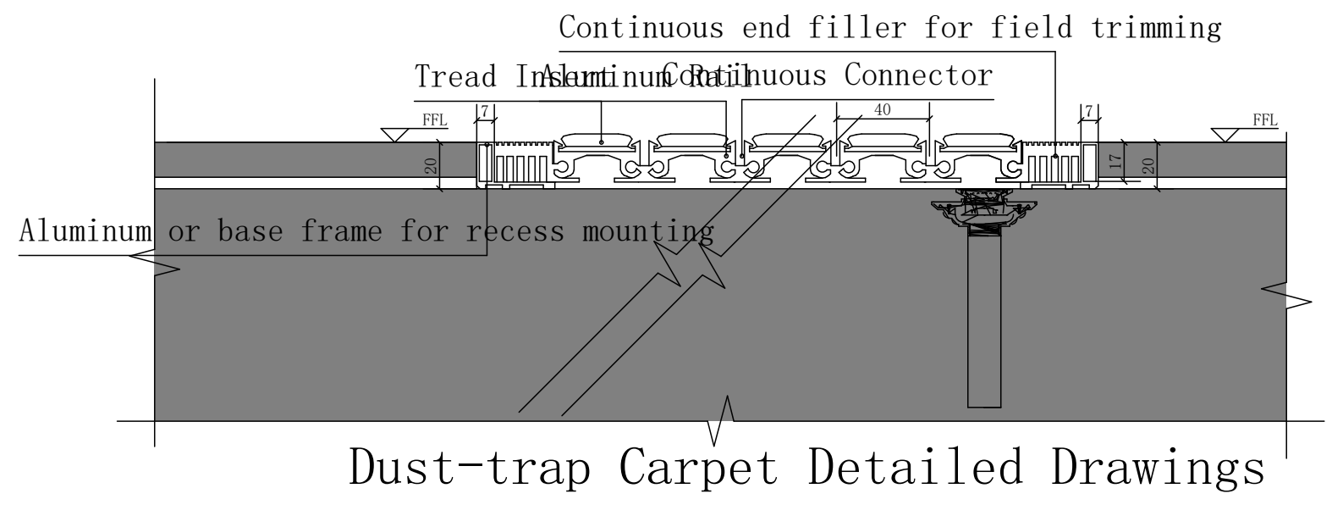
Continuous end filler for field trimming
Tread Insert
Aluminum Rail
Continuous Connector
Aluminum or base frame for recess mounting
FFL
FFL
7
7
40
20
17
20

Dust-trap Carpet Detailed Drawings

3RD FLOOR PHASING PLAN （DC BUILDING B）PART 1

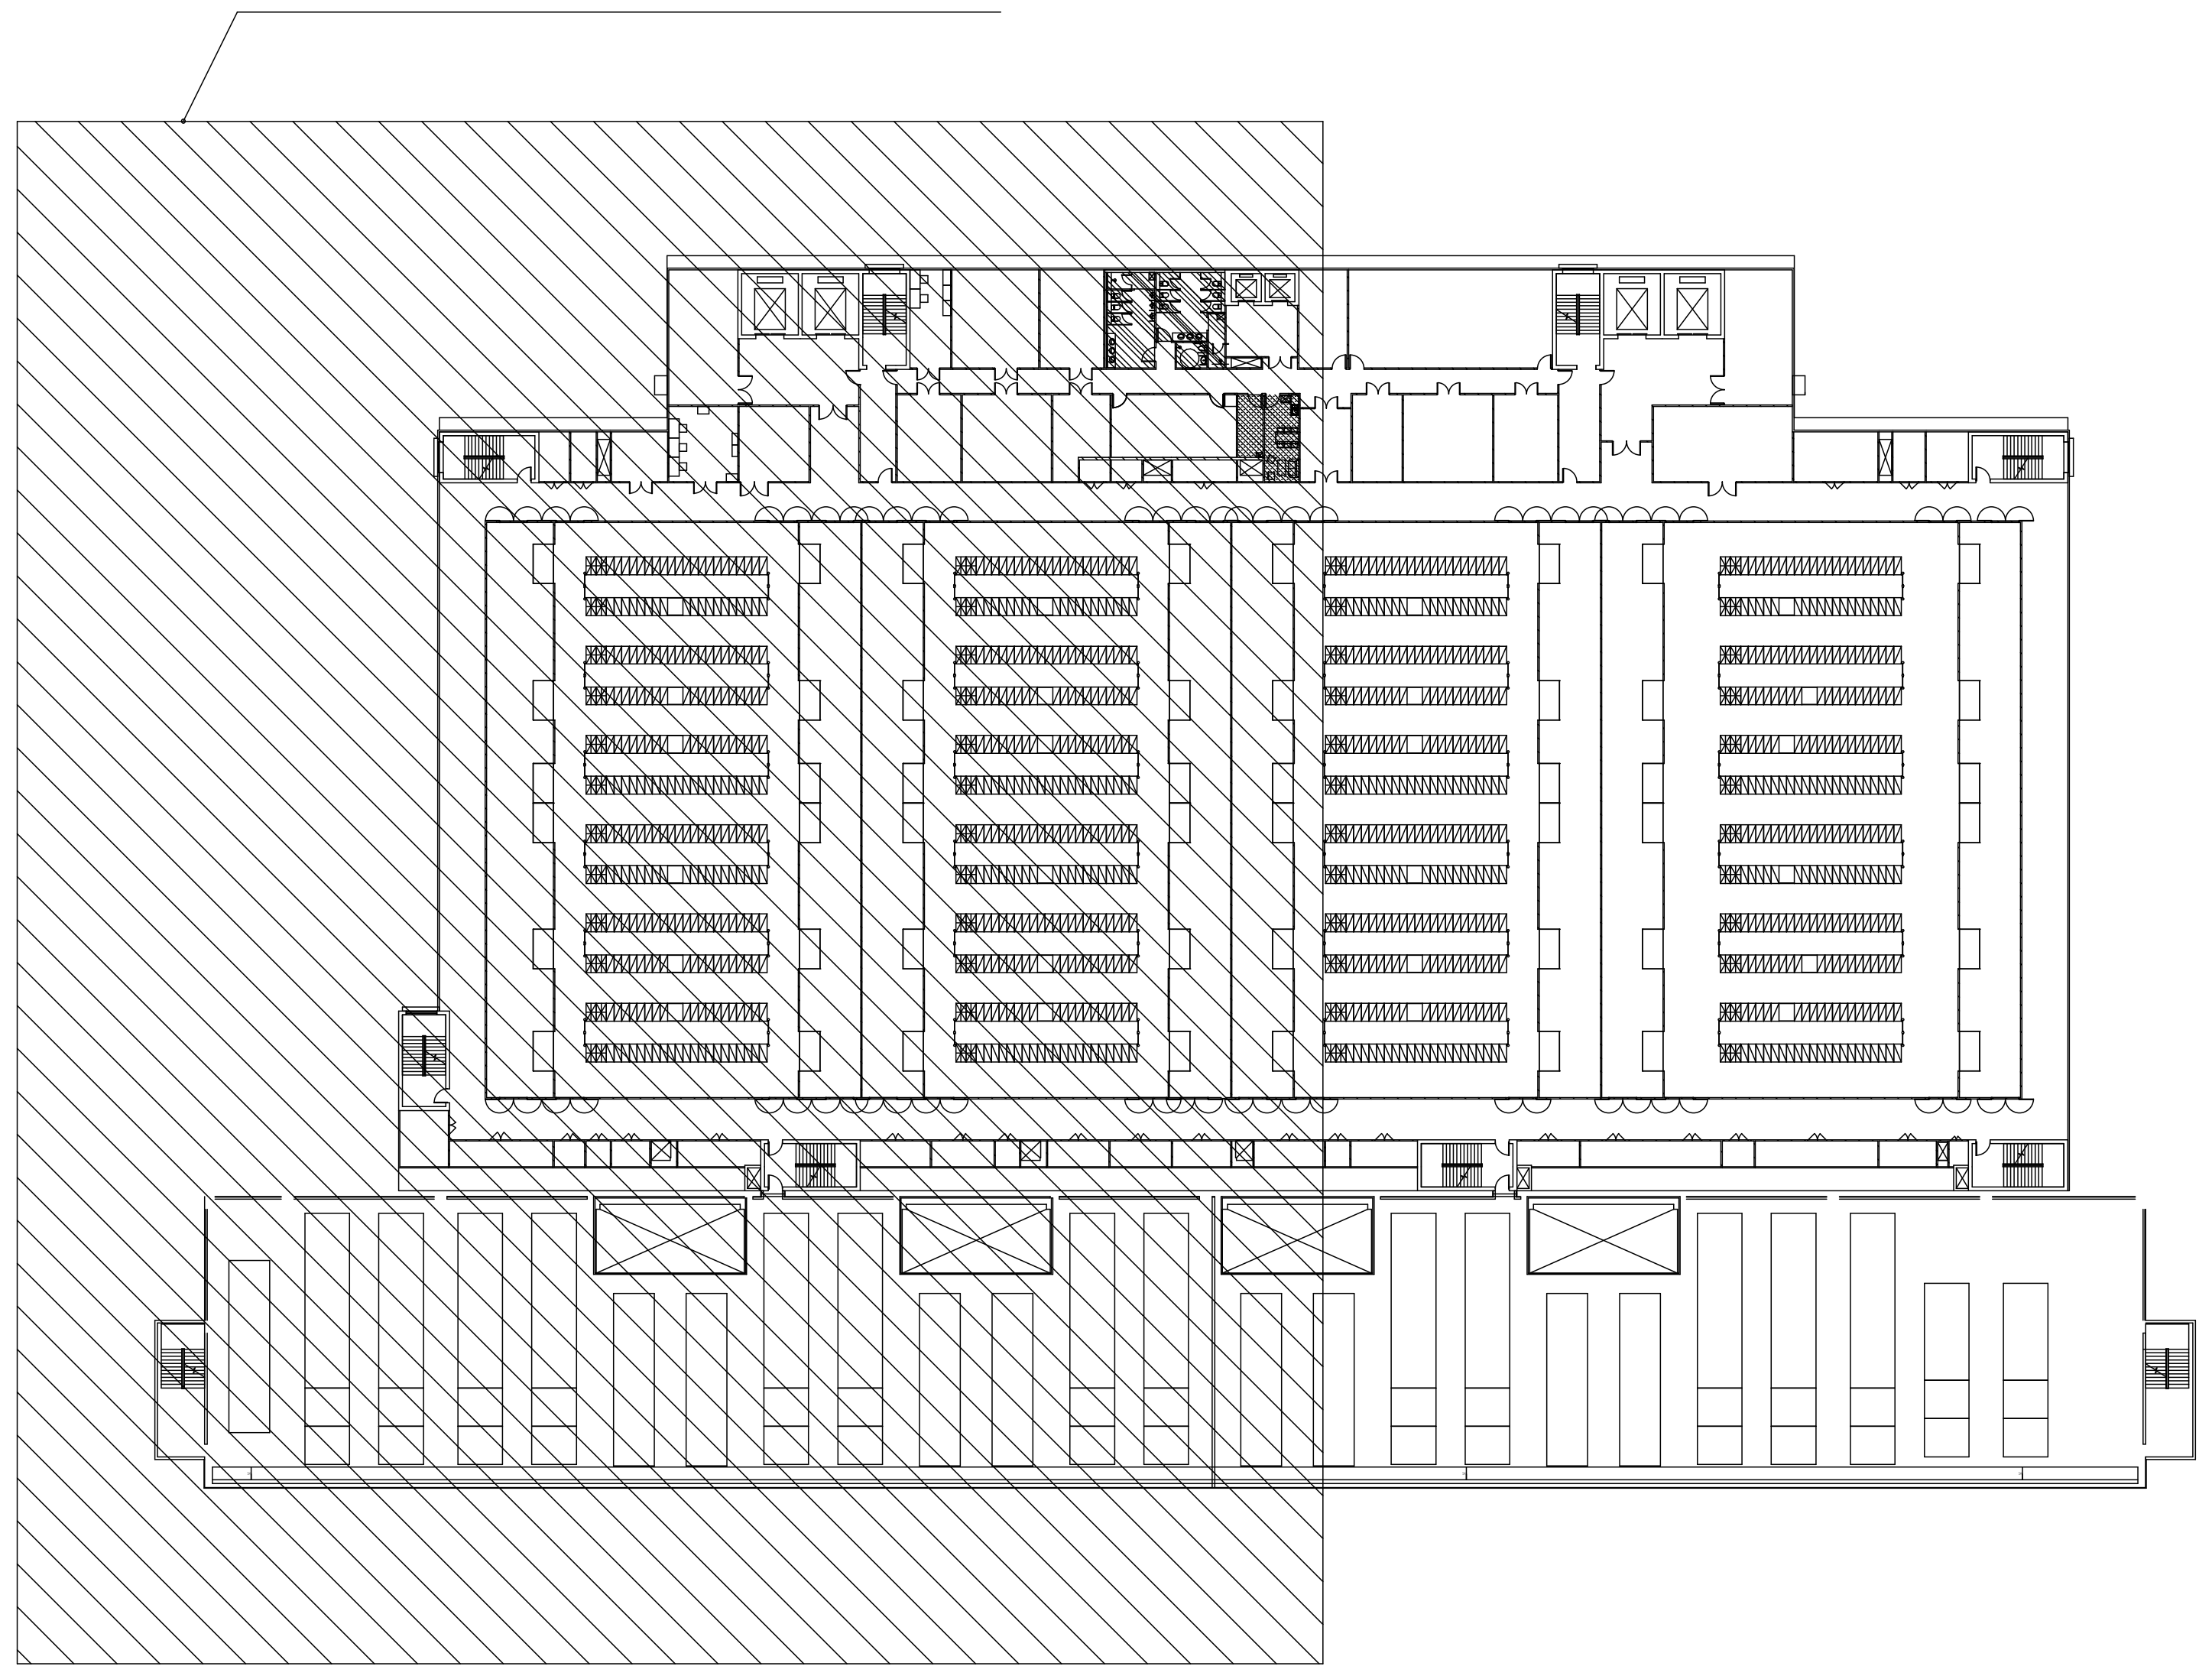

odified according to the review comments (ACM_GSA03_DesignReview_SD60_Rev B - Arch)

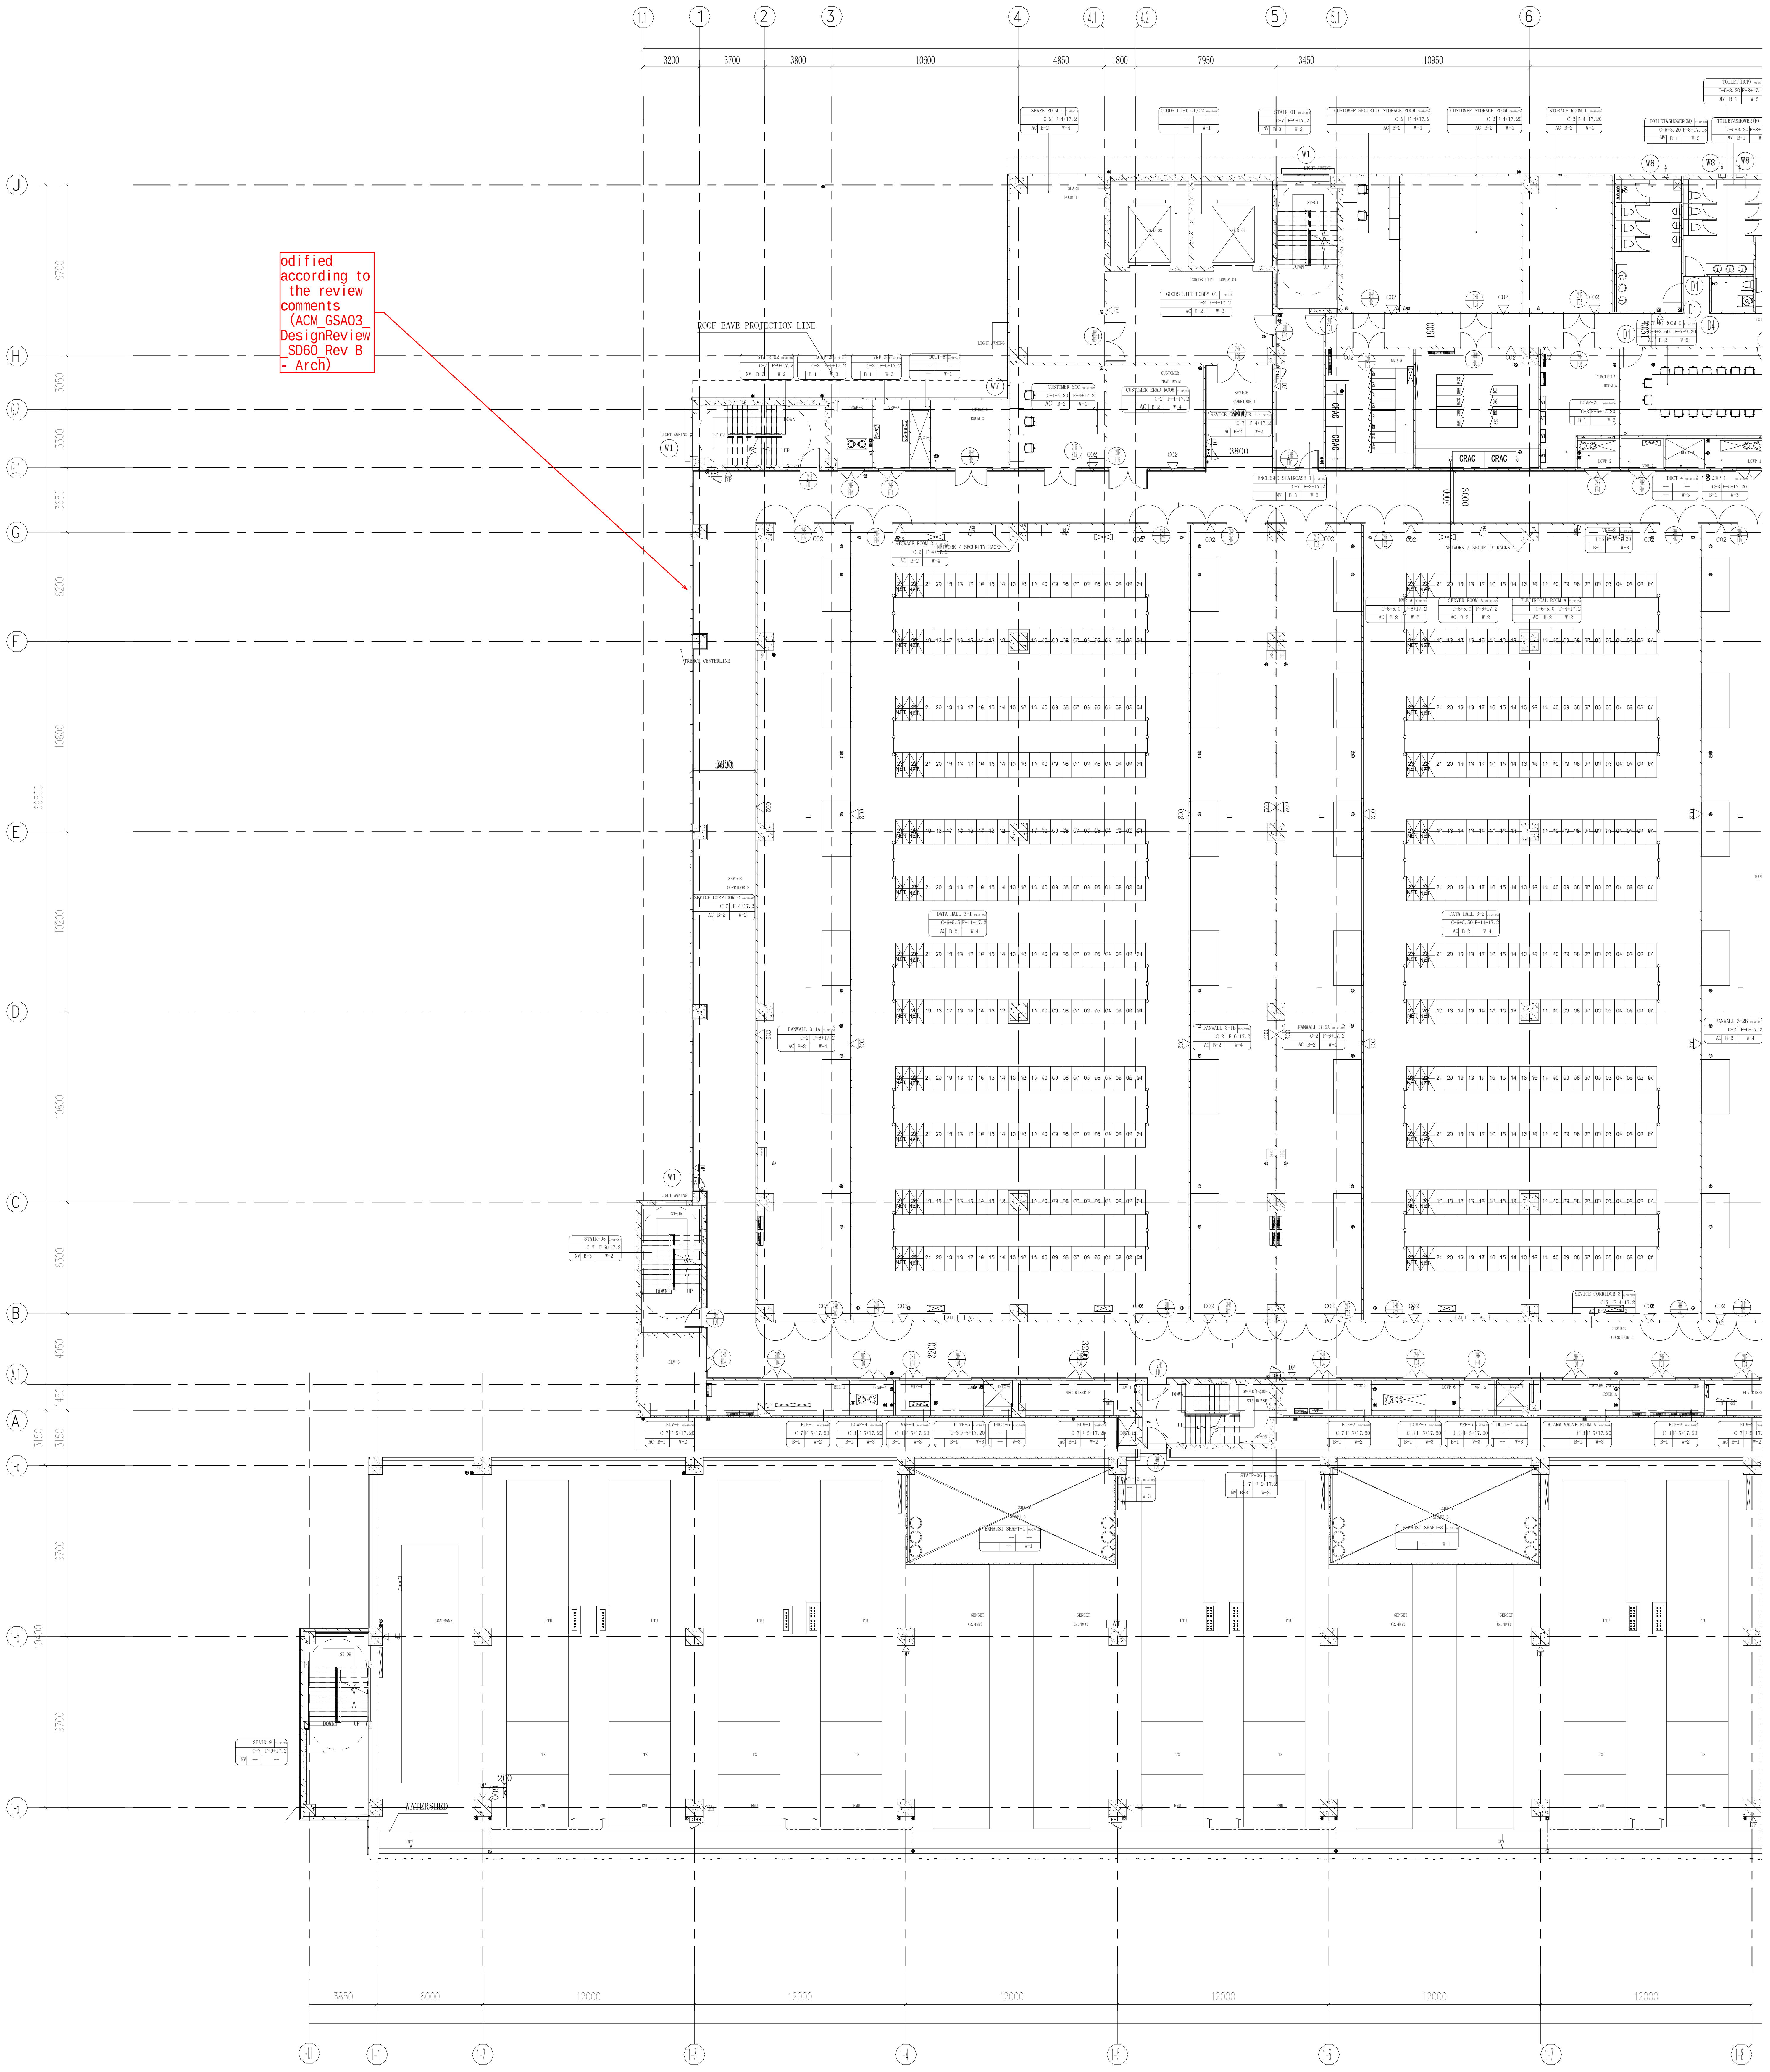

3RD FLOOR PHASING PLAN （DC BUILDING B）PART 1

SCALE 1:150

FLOOR AREA:12238.10 sqm
OVERALL GROSS FLOOR AREA:40900.20 sqm

CLIENT :
GULF EDGE DC 01
87 Wireless Road, M Thai Tower 11th. Floor, All Seasons Place, Lumpini, Pathumwan, Bangkok 10330, Thailand

CONTRACTOR :
华西发展(泰国)有限公司
บริษัท หัวซือ ดีเวลลอปเม้นต์ (ประเทศไทย) จำกัด
HUASHI DEVELOPMENT CO.,LTD
No. 202, Room No. 1403, 14/F, Le Concorde Building, Ratchadapisek Road, Huaykhwang Sub-District, Huaykhwang District, Bangkok Metropolitan 10310.

CONSULTANT :
ARbay
บริษัท เอ อาร์ เบย์ จำกัด
ARbay Company Limited
31 st Floor Bangkok Insurance Building
25 South Sathorn road Thungmahamek
Sathorn Bangkok 10120 THAILAND
T +66 (0) 2286 8199
F +66 (0) 2286 2863
info@arbay.co.th

CONSULTANT :
Qbic Engineers & Architects Co.,Ltd.
8 Soi KALONG 4 SANAMBINNAM ROAD,
THASAI SUB-DISTRICT, MUANG NONTHABURI DISTRICT
, NONTHABURI.
Tel 662-950-4374
Fax 662-580-3231
E-Mail : qbic@qbic.co.th, www.qbic.co.th
QBIC ENGINEERS AND ARCHITECTS CO.,LTD.

CONSULTANT :
MITR
MITR TECHNICAL CONSULTANT CO.,LTD.
1168/8 12th FLOOR, LUMPINI TOWER BUILDING,
RAMA IV RD., THUNGMAHAMEK, SATHORN, BANGKOK 10120, THAILAND
TEL : 0-2679-9079-84
FAX : 0-2679-9085 E-mail: mitr_dd@mitr.com

Architect : SIGNATURE
ประกิต พนานุรัตน์ วสถ. 580
ที่อยู่
251/1 ถ.จารุเมือง แขวงรองเมือง เขตปทุมวัน
กรุงเทพมหานคร โทรศัพท์ 02-286-8199

Structural Engineer : SIGNATURE
วิศวกรผู้ออกแบบโครงสร้าง
ณัฐสม สงวนวงษ์ วย 1423
ที่อยู่
2/1 ซ.รามคำแหง 150 ถ.รามคำแหง
แขวง สะพานสูง เขต สะพานสูง กทม. 10240

Structural Inspector : SIGNATURE
วิศวกรผู้ตรวจสอบโครงสร้าง
โกมล จุฑาภัทร วย 964
ที่อยู่
24/18 ซ.นวมินทร์ 129 ถ. นวมินทร์
แขวง นวลจันทร์ เขต บึงกุ่ม กทม. 10230

Electrical Engineer : SIGNATURE
วิศวกรผู้ออกแบบระบบไฟฟ้ากำลัง
นายสุภัทร บูรณวิทย์ วฟก.1265
ที่อยู่
21 ซอยทานสัมฤทธิ์ 13
ตำบลท่าทราย อ.เมืองนนทบุรี จ.นนทบุรี 11000

Mechanical Engineer : SIGNATURE
วิศวกรผู้ออกแบบระบบเครื่องกลและปรับอากาศ
นายประสิทธิ์ เกี้ยวสุนทร วก.1221
ที่อยู่
44/372 ซอยบางกระดี่ 35/1 แขวงแสมดำ
เขตบางขุนเทียน กทม. 10150
ประสิทธิ์

Sanitary Engineer : SIGNATURE
วิศวกรผู้ออกแบบระบบสุขาภิบาล และดับเพลิง
นายทศวรรษ สนั่นฤทธิ์ วส. 215
ที่อยู่
บ้านเลขที่ 99/107 หมู่ที่ 3 ต.ศีรษะจรเข้น้อย
อ.บางเสาธง จ.สมุทรปราการ 10540
ทศวรรษ

ISSUE/REVISION

REV.	DESCRIPTION	DATE
A	90% DEVELOPED	09/05/2026

PROJECT NAME :
GEDC 01

LOCATION:
Nikhom Phattana district, Rayong ,industrial estate,CPGC

BUILDING :
MAIN BUILDING

90% DEVELOPED

TITLE :
3RD FLOOR PHASING PLAN (DC BUILDING B)PART 1

JOB NO.		SCALE	1 : 150
DRAWN	KHJ	REF.	
CHECKED	LJC	DWG. NO.	MPK01B-90-A-P-302
APPROVED	LXD		
DATE	2026.05.09		

NOTE :THIS PRINT IS OF A CONFIDENTIAL NATURE, IT SHALL NOT BE TRACED,PHOTOGRAPHED,PHOTOSTATED OR REPRODUCED IN ANY MANER,NOR USED FOR ANY PURPOSE WHATSOEVER EXCEPT BY WRITTEN PERMISSION