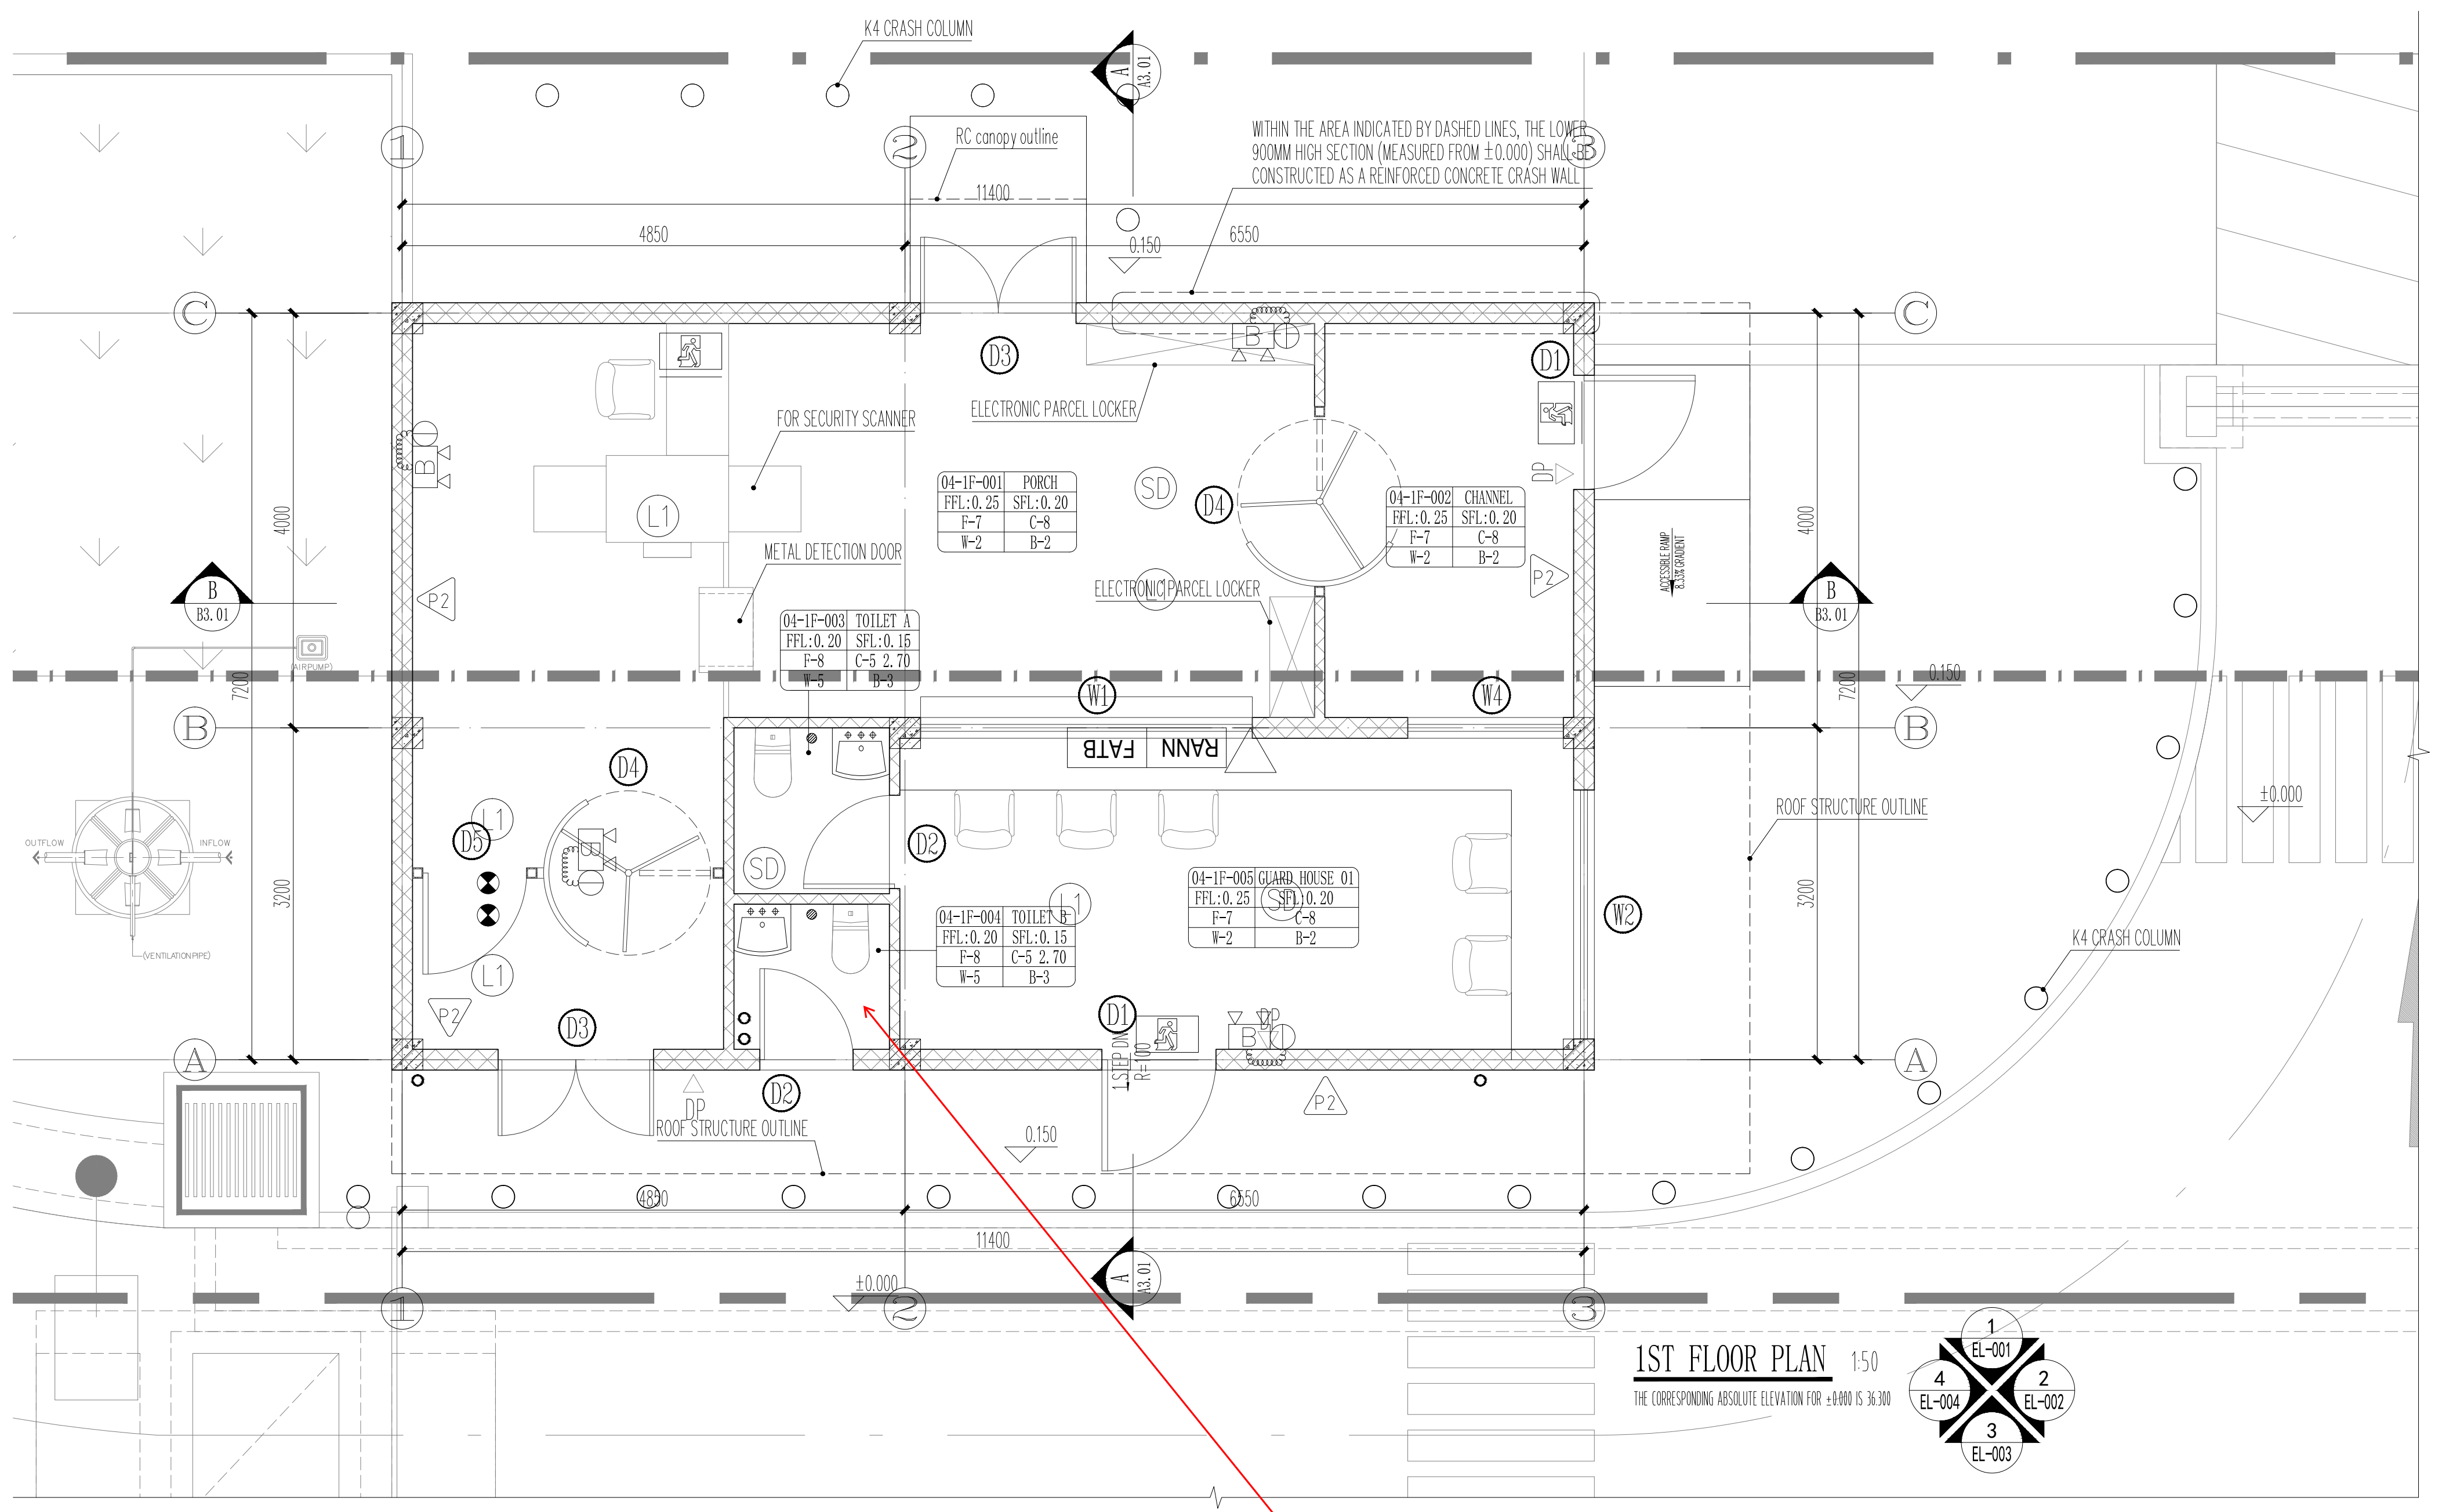
1ST FLOOR PLAN 1:50
THE CORRESPONDING ABSOLUTE ELEVATION FOR ±0.000 IS 3.30
X4 CRASH COLUMN
RC canopy outline
WITHIN THE AREA INDICATED BY DASHED LINES, THE LOWER 900MM HIGH SECTION (MEASURED FROM ±0.000) SHALL BE CONSTRUCTED AS A REINFORCED CONCRETE CRASH WALL
FOR SECURITY SCANNER
ELECTRONIC PARCEL LOCKER
METAL DETECTION DOOR
ROOF STRUCTURE OUTLINE
X4 CRASH COLUMN
FATB
RANN
11400
4850
6550
4000
3200
7200

Modified according to the review comments (ACM_GSA03_DesignReview_SD60_Rev B - Arch)

DOOR SCHEDULE		
	DESCRIPTION	SISE(MM) WIDTH X HEIGHT
D1	G.I METAL FRAME SINGLE LEAF SOLID STEEL DOOR PANEL	1100 X 2400
D2	METAL FRAME WATER RESISTANT TMBERFLUSH DOOR TO MANUF'S DETAIL	900 X 2200
D3	G.I METAL FRAME SINGLE LEAF SOLID STEEL DOOR PANEL SHALL MEET BULLETPROOF REQUIREMENTS	1500 X 2400
D4	S/S FRAME WTH S/S REVOLVING DOOR TO MANUF'SDETAIL AND ARCH'S APPROVAL	1700 X 2400
D5	S/S FRAME WITH S/S SWING DOOR TO MANUF'S DETAIL AND ARCH'S APPROVAL	1050 X 2400
W1	FORCED-ENTRY CLASS WNDOW TO MANUF'SDETAIL(BULLET PROOF GLASS)	2100 X 1100
W2	FORCED-ENTRY CLASS WNDOW TO MANUF'SDETAIL(BULLET PROOF GLASS)	2400 X 1100
W3	1.4MM THK. POWDER COATED ALUMN. FRAME WITH 6MM THK. DARK GREY TINTED TEMPERED GLASS TOP HUNG WINDOW TO MANUF'S DETAIL	600 X 600
W4	FORCED-ENTRY CLASS WNDOW TO MANUF'SDETAIL(BULLET PROOF GLASS)	1500 X 1100

Floor No.	Description	Floor Finish Specification	Vender
F-7	Ceramic Tile	600x600 Ceramic Tile On Concrete Steel Trowel Finish; Low Voc Content & Emission Adhesive	
F-8	Porcelain Tile	600x600 12mm Thk Non-slip Homogenous Tile (r10) On Waterproofing,Low Voc Tile Adhesive And Grout	
F-15	Concrete Roof+ Waterproofing	SELF-ADHESIVE POLYMER-MODIFIED BITUMEN WATERPROOFING MEMBRANE(3+3mmTHK.)+NON-CURING RUBBER ASPHALT WATERPROOF COATING(2mmTHK.)+XPS INSULATION BOARD(75mmTHK R-12(12 BTU/(h·°F·ft2)(2.12(K·m2)/W))Or Better)+REINFORCED CONCRETE COVER(50mm THK For Roof Slab Top Coat With TOA Heatshield Paint SRI≥82）（XPS insulation board density ≥ 30 kg/m³, compressive strength ≥ 250 kPa）	

Wall No.	Description	Wall Material & Structure Specification	Vender
P2	200MM THK. BRICKWALLWITH PLASTERED(U-value < 0.5 W/(m²·K)		Local
P3	Uac Precast Wall	100mm.Thk Autoclaved Aerated Concrete Wall Panel,2hr.Fire Rated Low Voc Content & Emission Insulation,Low Voc Content & Emission Silicone Sealant	

Ceiling No.	Description	Ceiling Material & Finish Specification	Vender
C-5	ALUMINIUM BUCKLE PLATE CEILING	MOISTURE PROOF ALUMINIUM BUCKLE PLATE CEILING + ANTI-DUST PAINT SOFFIT	
C-8	EXPOSED CEILING	EXPOSED CEILING, SKIM COATED LOW VOC CONTENT & EMISSION PAINT	

Wall No.	Description	TILE SIZE(MM) WIDTH X DEPTH
W-2	Skim Coat With Scrub Resistant Paint	Scratch-resistant
W-5	12mm Thk Waterproof Homogenous Tile	Waterproof
WF-1	EXTERIOR WALL PAINT	

BASEBOARD (SKIRTING) FINISHES		
CODE	Finish	HEIGHT(MM)
B-2	Stainless Steel	
B-3	Non-slip Homogenous Tile (R10)	

Note On Levels- All Levels Shown Are Absolute Elevation	
SD	SURFACE MOUNTED SMOKE DETECTOR, PHOTOELECTRIC TYPE
L1	- CEILING MOUNTED LOUDSPEAKER 6W TYPE L1
B	SELF-CONTAINED SEALED LEAD ACID BATTERY EMERGENCY LIGHT 2x9W LED LAMPS WITH 2-HOURS BACK UP TIME,BUILT-IN ADDRESSABLE MODULE THE LIGHTING FIXTURE COMES WITH A BATTERY MONITORING SYSTEM
🚶	LED EXIT SIGN LUMINAIRE, WALL OR SUSPENDED MOUNTED (SINGLE SIDE) WITH 2-HOURS BACK UP TIME,BUILT-IN ADDRESSABLE MODULE,THE LIGHTING FIXTURE COMES WITH A BATTERY MONITORING SYSTEM
▨	REINFORCED CONCRETE STRUCTURAL COLUMN
⊗	SURFACE OR SUSPENDED MOUNTED EMERGENCY REMOTE LAMP 3W LED WITH 2-HOURS BACK UP TIME,BUILT-IN ADDRESSABLE MODULE,THE LIGHTING FIXTURE COMES WITH A BATTERY MONITORING SYSTEM
▽	TELEPHONE OUTLET, RJ 11 TYPE
RANN	REMOTE GRAPHIC ANNUNCIATOR BOARD
FATB	FIRE ALARM TERMINAL BOX
●	FLOOR DRAIN
	WATER CLOSET (W.C.) — SUPPLIED BY SPECIALIST MANUFACTURER
	WASHBASIN — SUPPLIED BY SPECIALIST MANUFACTURER

~~ANTI TERMITE TREATMENT :~~

ANTI TERMITE TREATMENT SHALL BE EXECUTED BY APPROVED APPLICATOITHE CONTRACTOR SHALL ALLOW FOR :
1. WORKING IN 4-STAGES
2.PROVSIONOFA FIVE (5L VEARS ONT UARANIEE BY MANUJACLER AND APPICAOR COMMENCING FROMTHE DALE OF CERFICALE OF PRACICAL COMPEION ON QUALLY OF MAIERALS AND STANDARD OF WOKMANSHIL
3. PROVISION OF TREATMENT AGAINST TERMITE ATTACK DURING THE QUARANTEE PERIOD FREE OF CHARGE TO THE EMPLOYER THE TERMITICIDE TO BE USED IS "HEXTAR" OR APPROVED EQUIVALENT LMIDACLOPNID: AT A DILUTION RATE OF 1:800: TO COMPLY WITH THE SPECIALIST REQUIREMENTS TREATMENT METHOD:POWER SPRAY THE COMPACTED SOIL SURFACE AT THE RATE OF 5 LITRES/M2 OF TERMICIDE AT THE CORRECT CONCENTRAION FOR EVERY SQUARE METER POWER SPRAY THE COMPACTED SOILSURFACE FOR PILE CAP, GROUND BEAM, GROUND FOOR, AND APRON AT THE RATE OF 5 ITRESLM2 OF TEMITICIDE FOR EVERY SOUARE METER;

LEED Note:
1 All adhesives, sealants, paints, primers, and coatings shall be low-VOC content and low-VOC emissions materials.
2 All ceiling boards shall be low-VOC emissions materials.
3 Used at least 20 EPD products from 5 manufacturers.
4 All materials shall comply with LEED TOR.

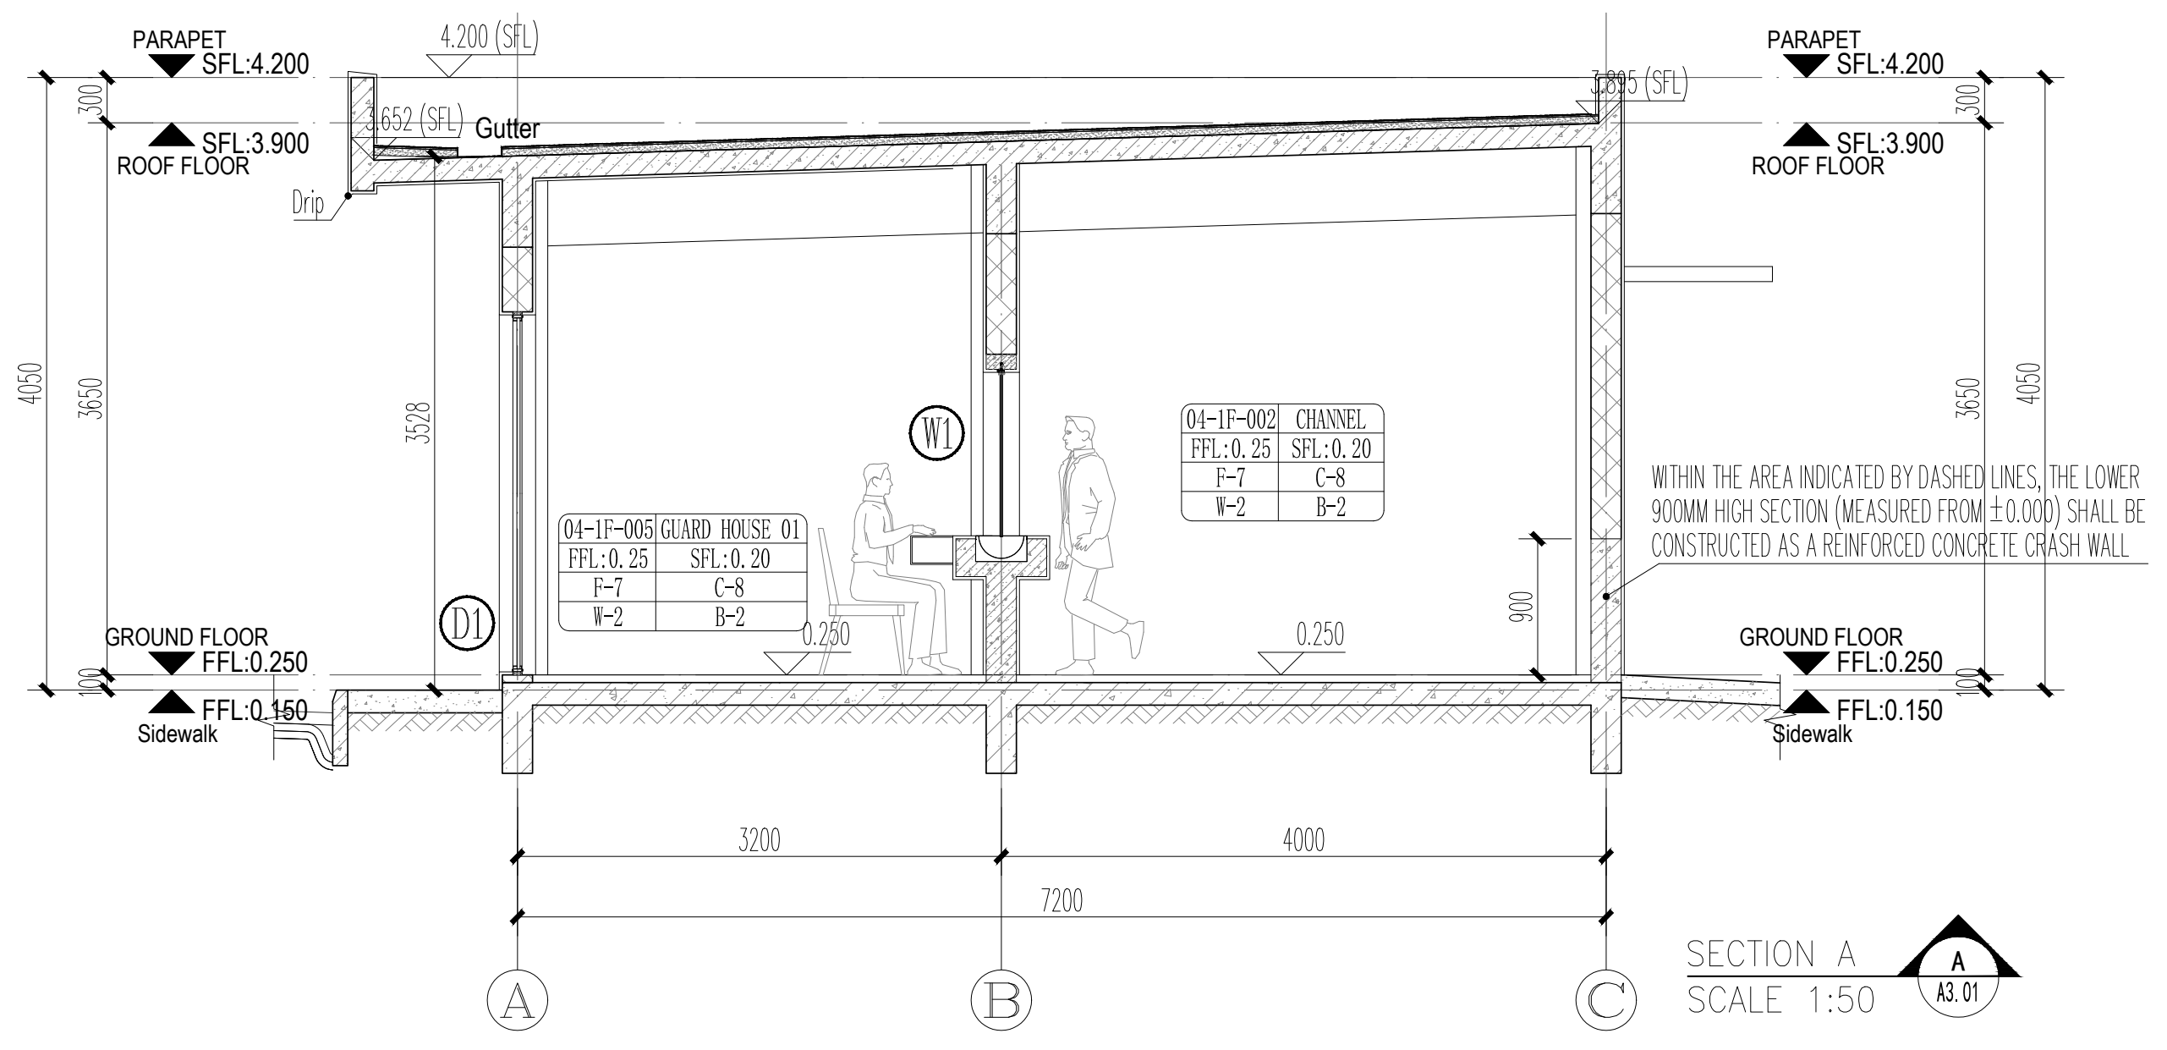
SECTION A SCALE 1:50
PARAPET SFL:4.200
SFL:3.900 ROOF FLOOR
Gutter
Drip
GROUND FLOOR FFL:0.250
FFL:0.150 Sidewalk
WITHIN THE AREA INDICATED BY DASHED LINES, THE LOWER 900MM HIGH SECTION (MEASURED FROM ±0.000) SHALL BE CONSTRUCTED AS A REINFORCED CONCRETE CRASH WALL
3200
4000
7200
A
B
C

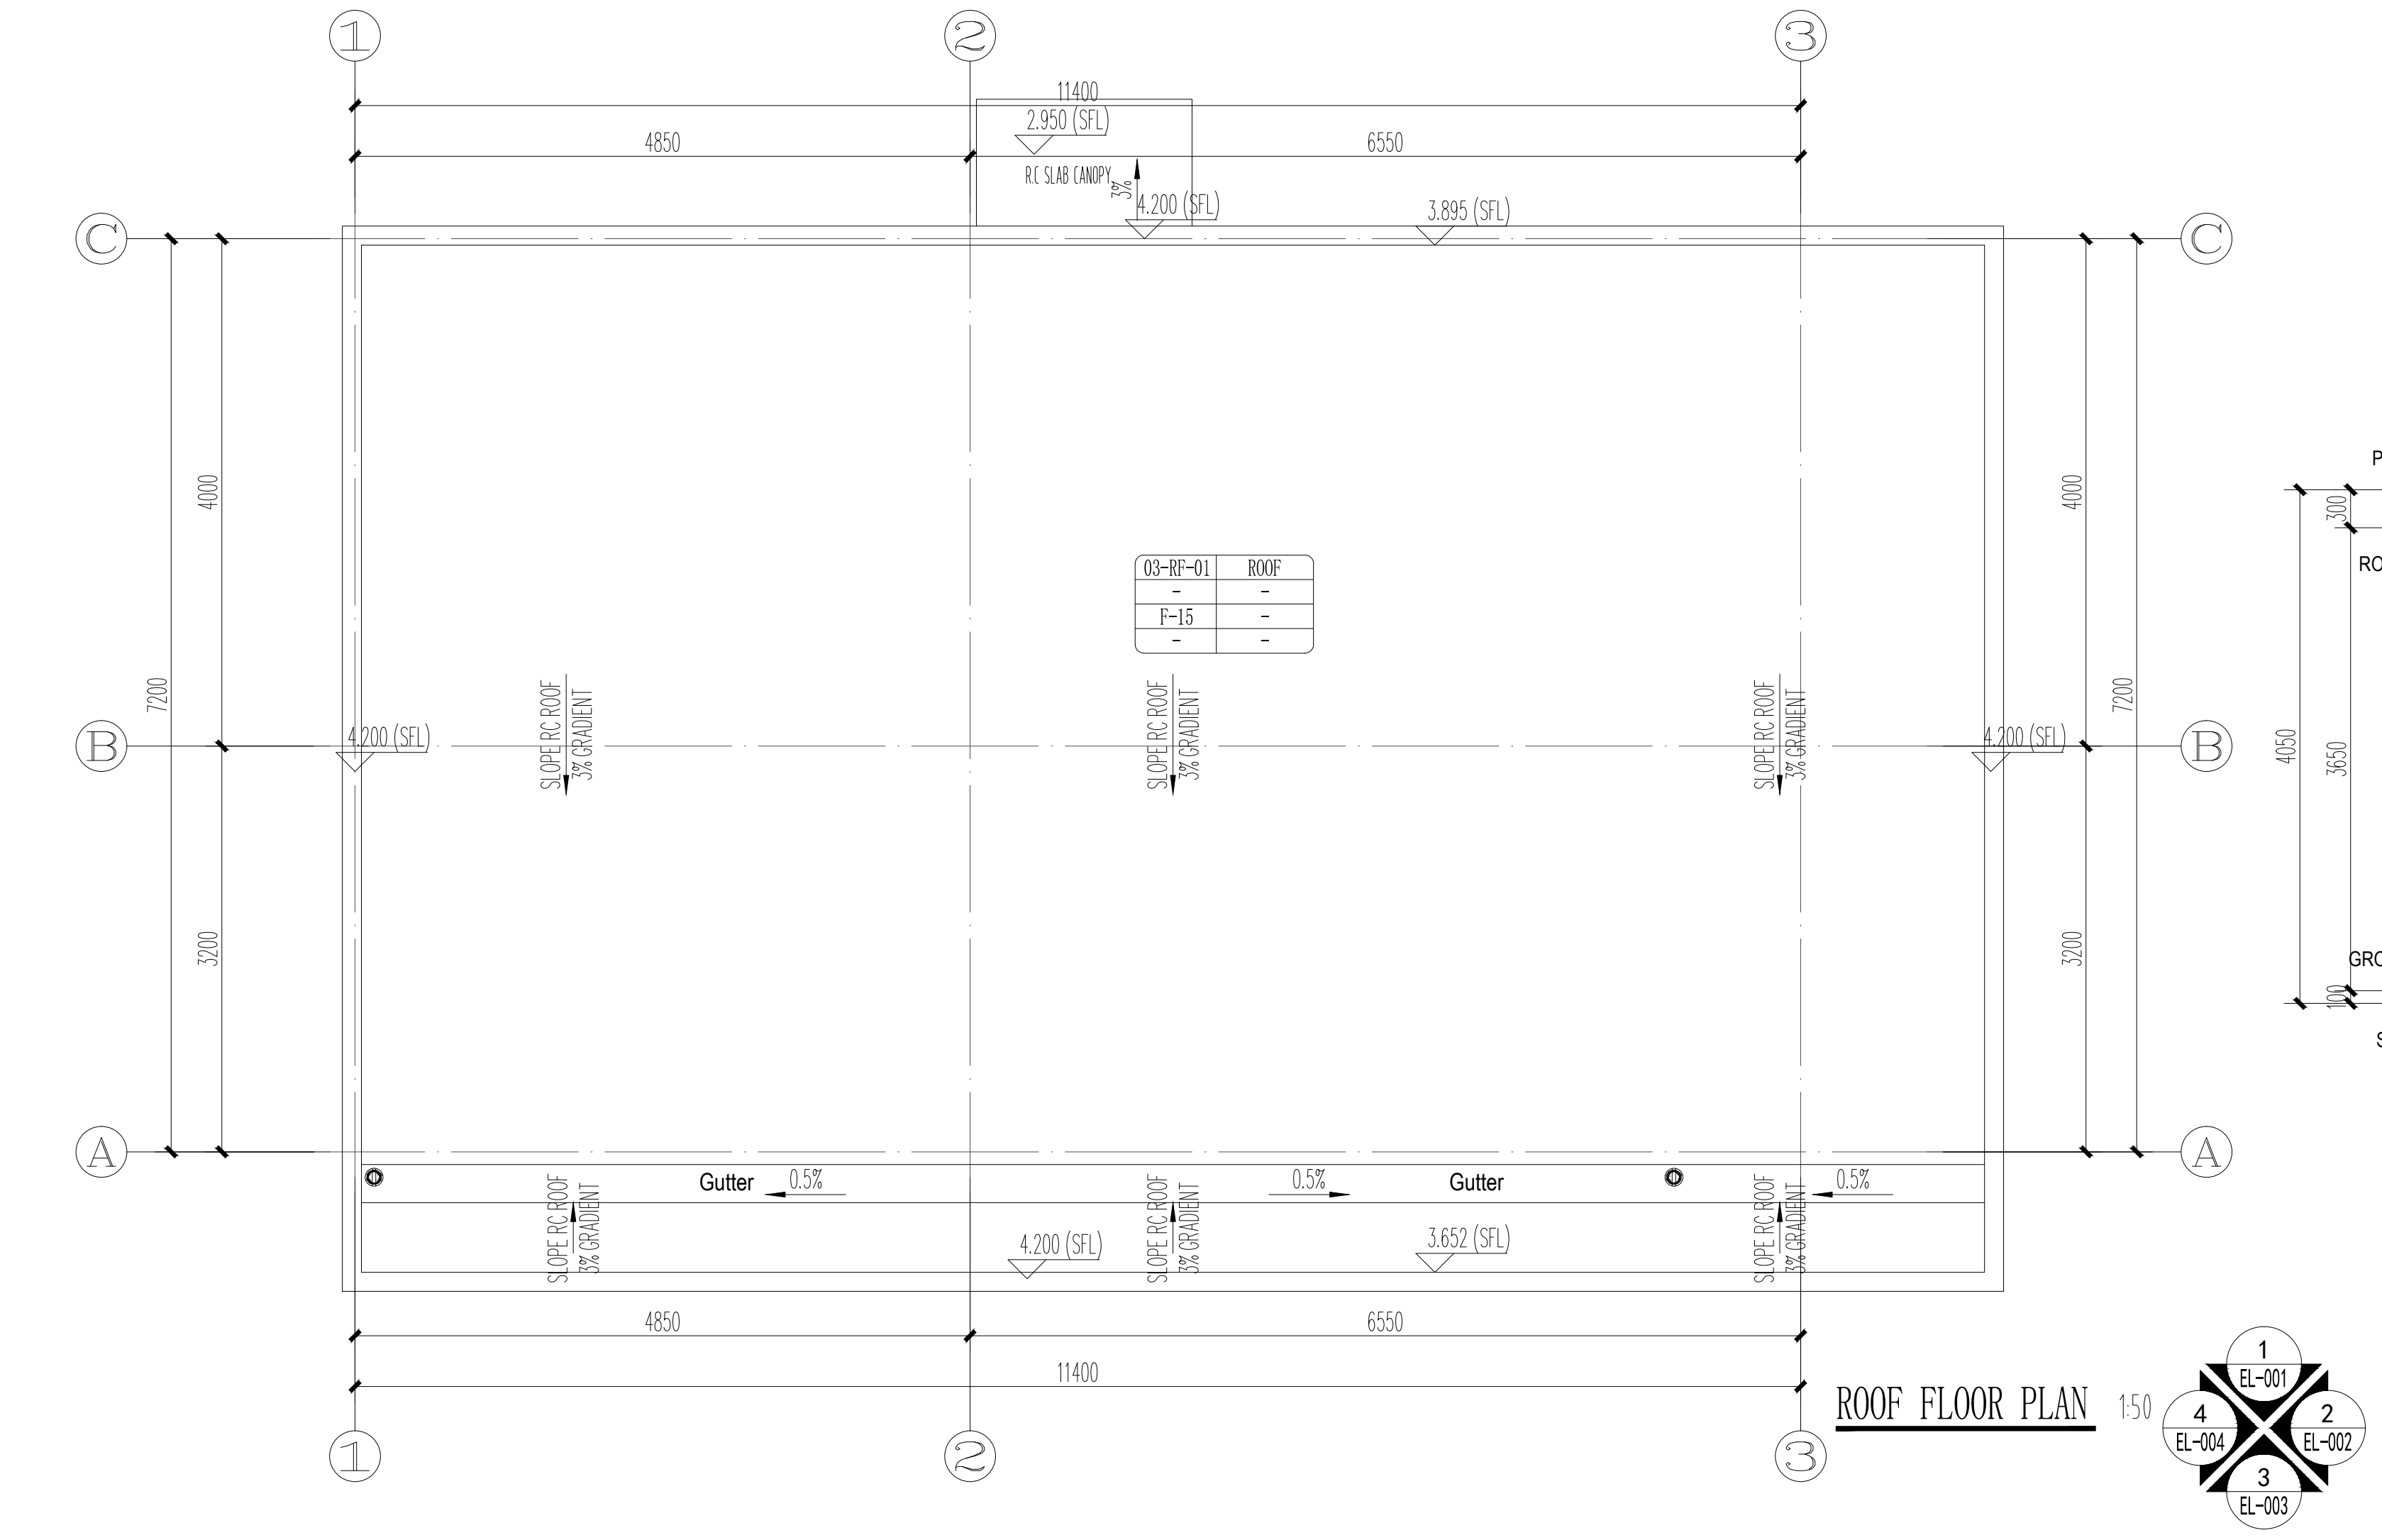

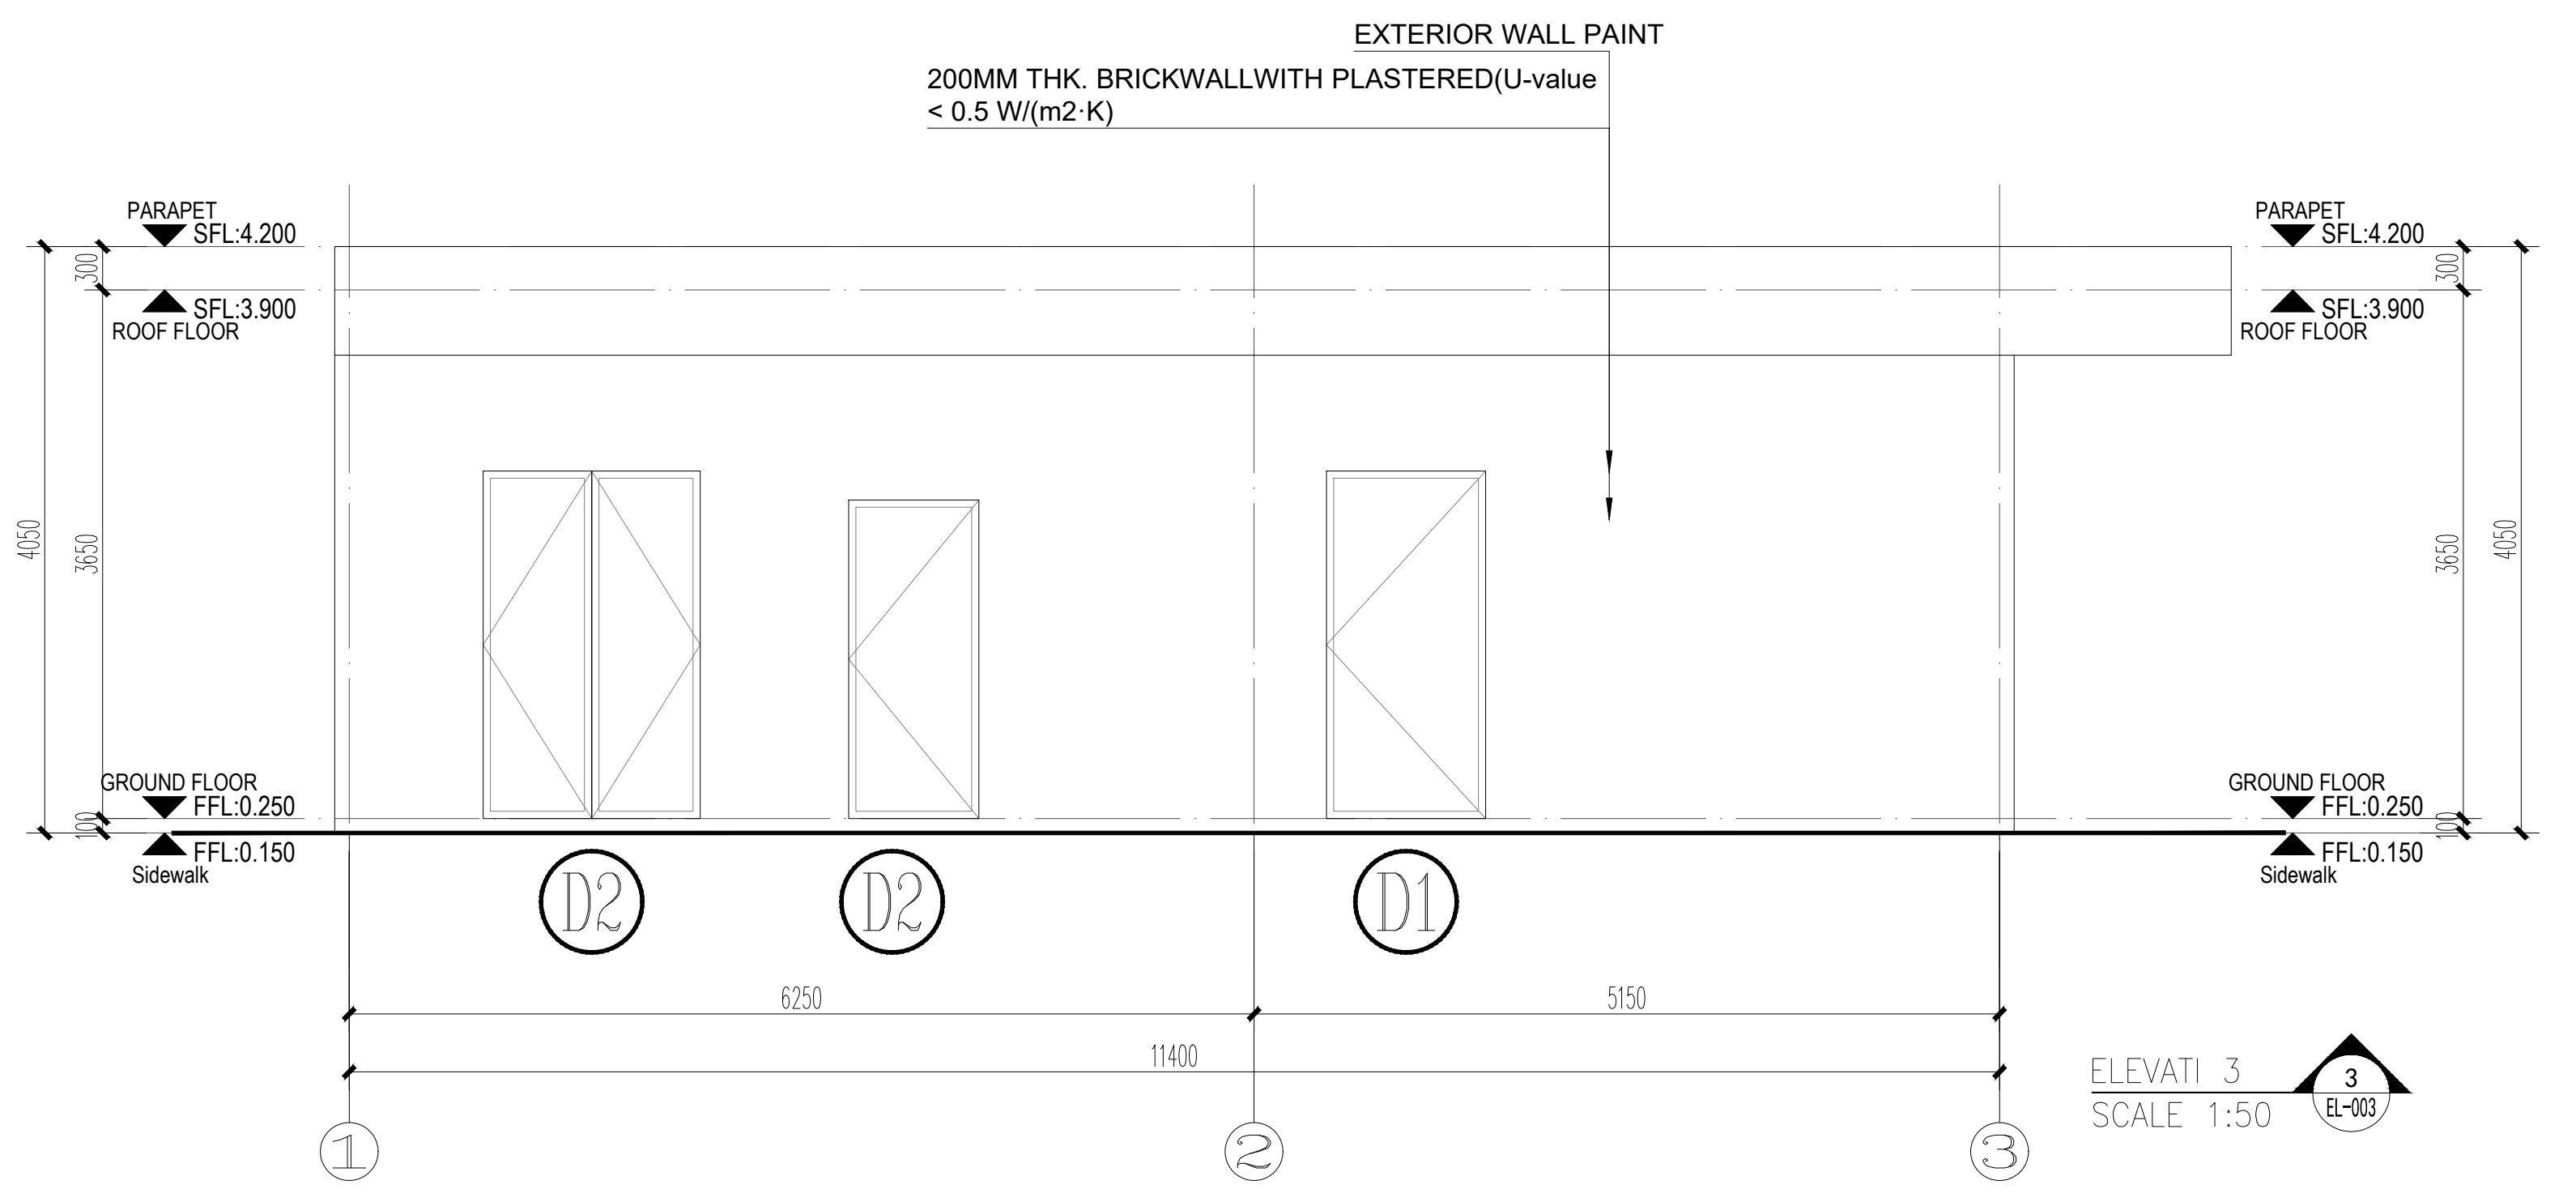

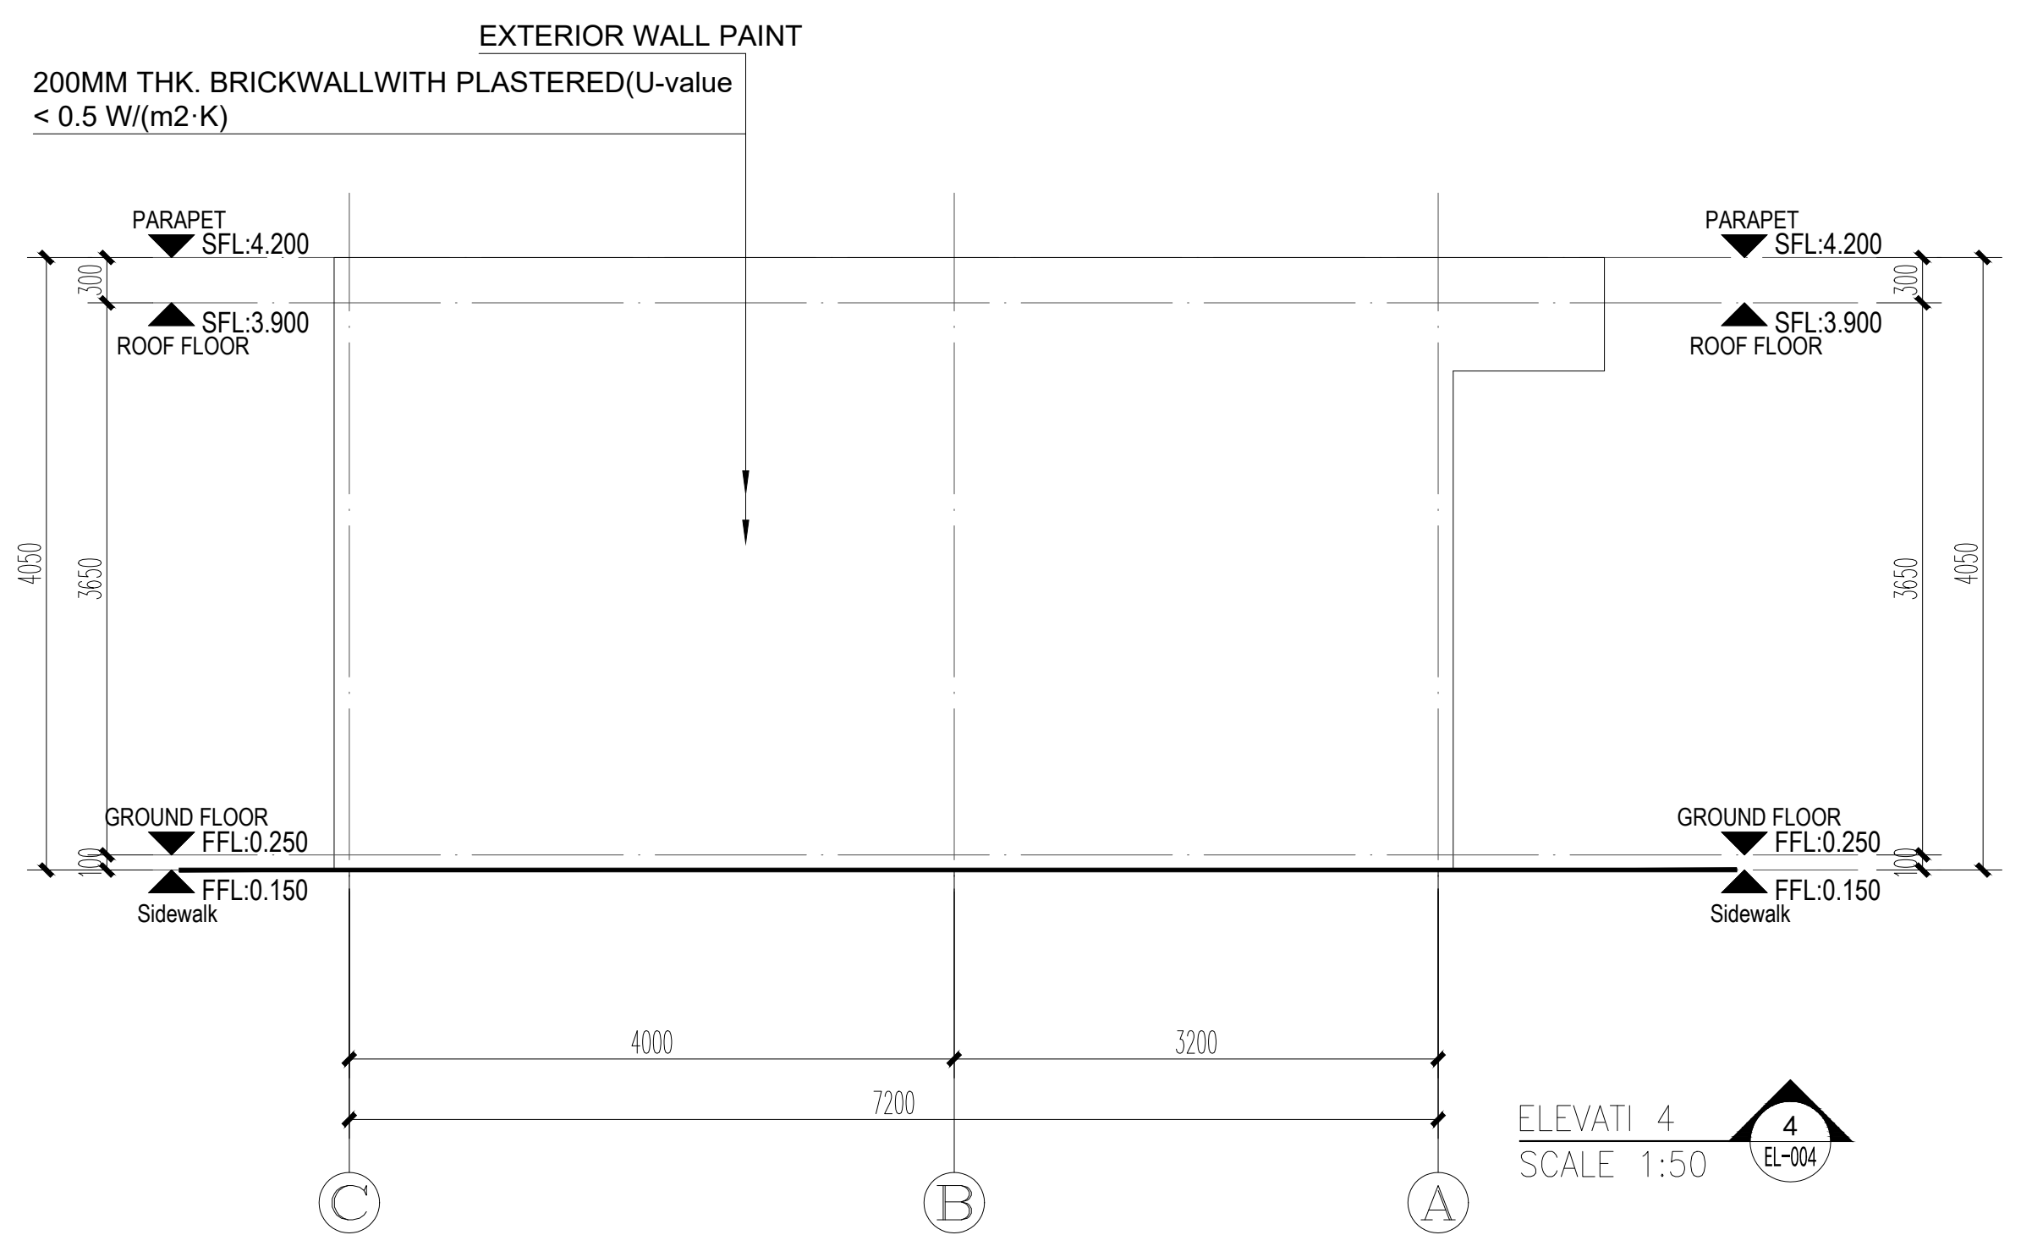

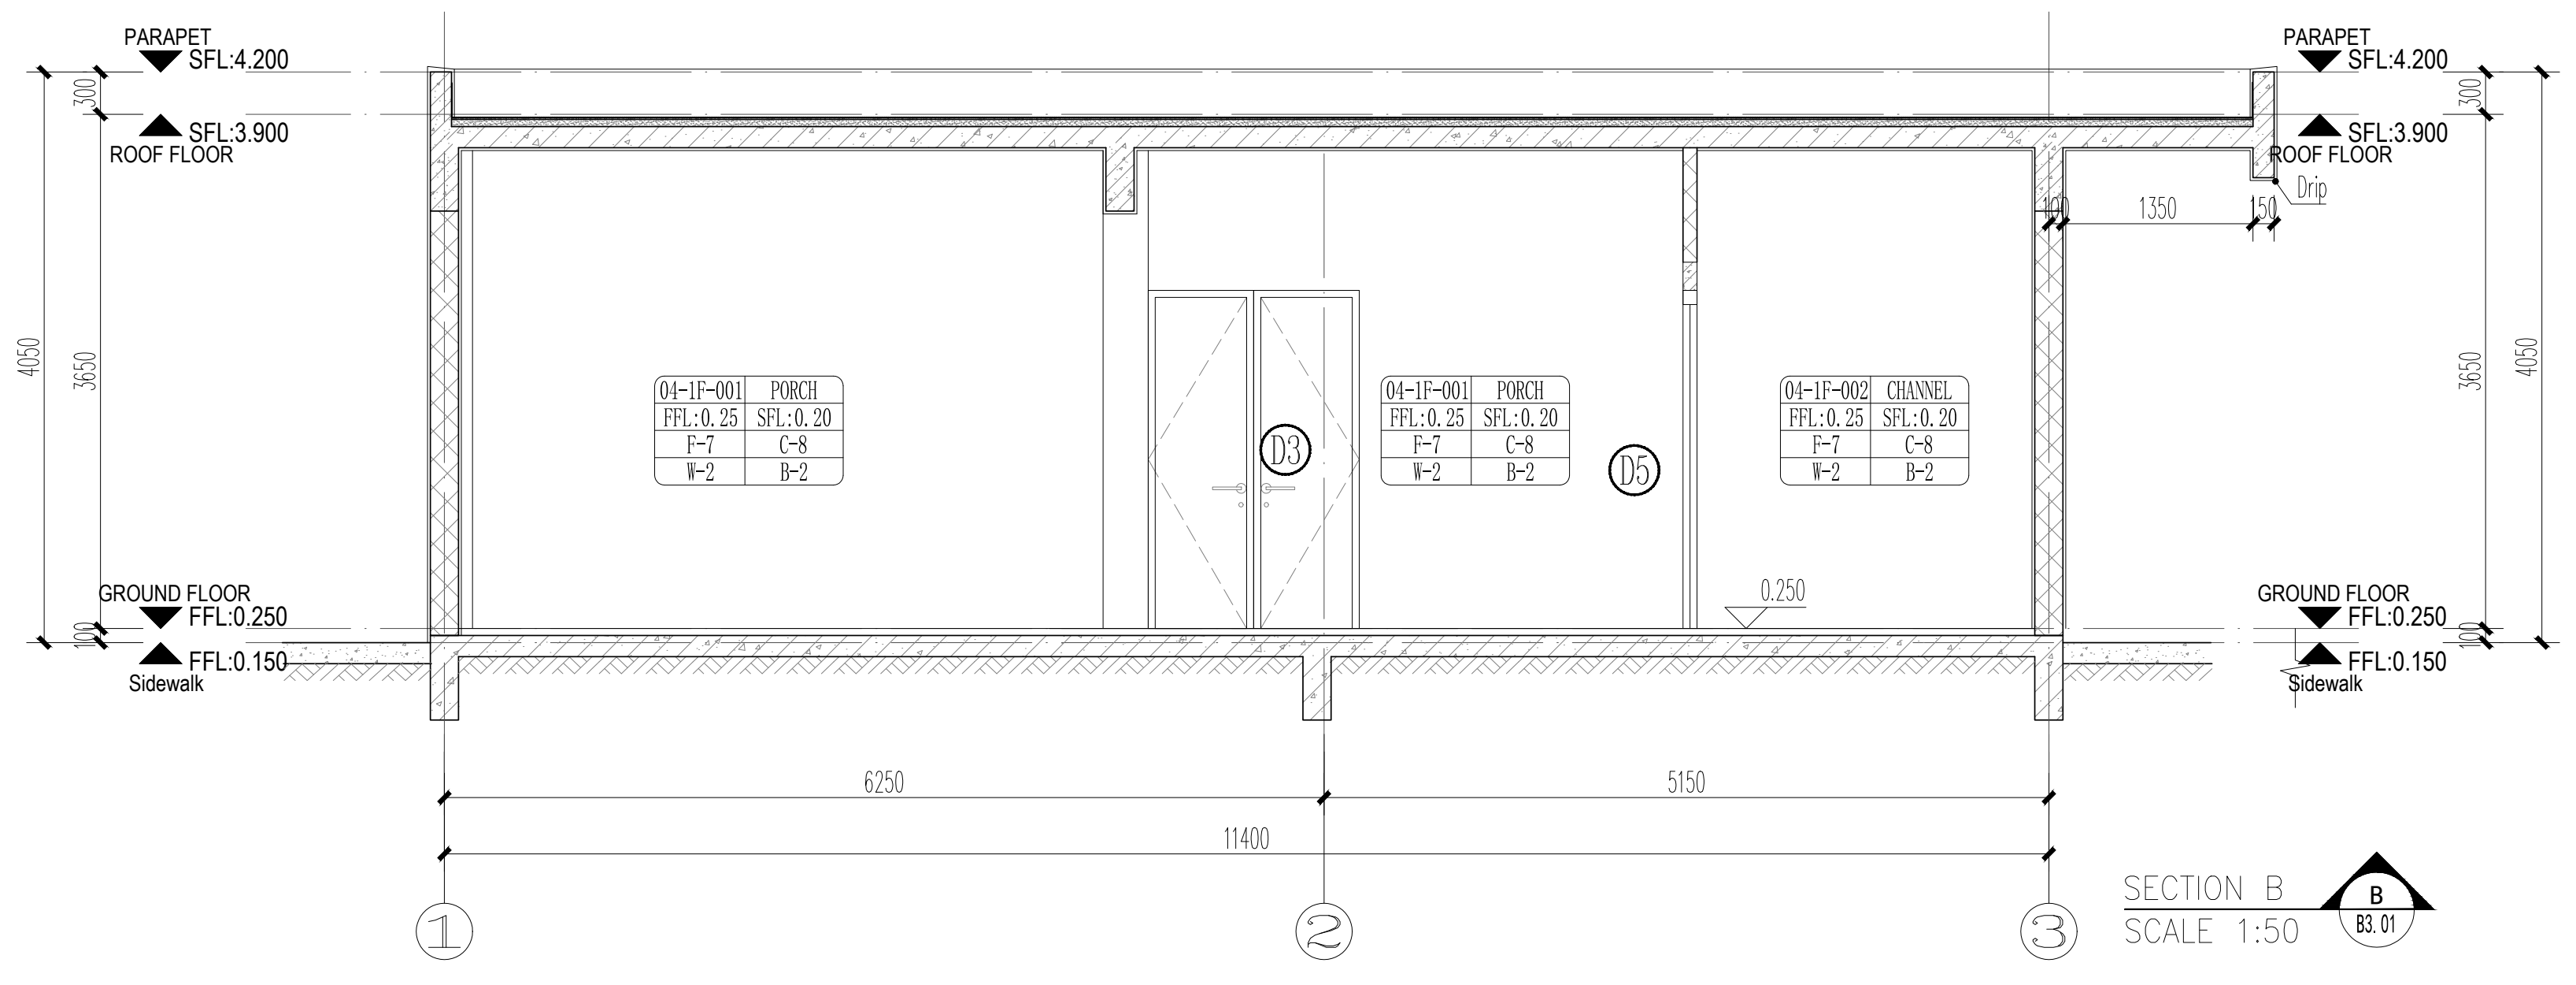

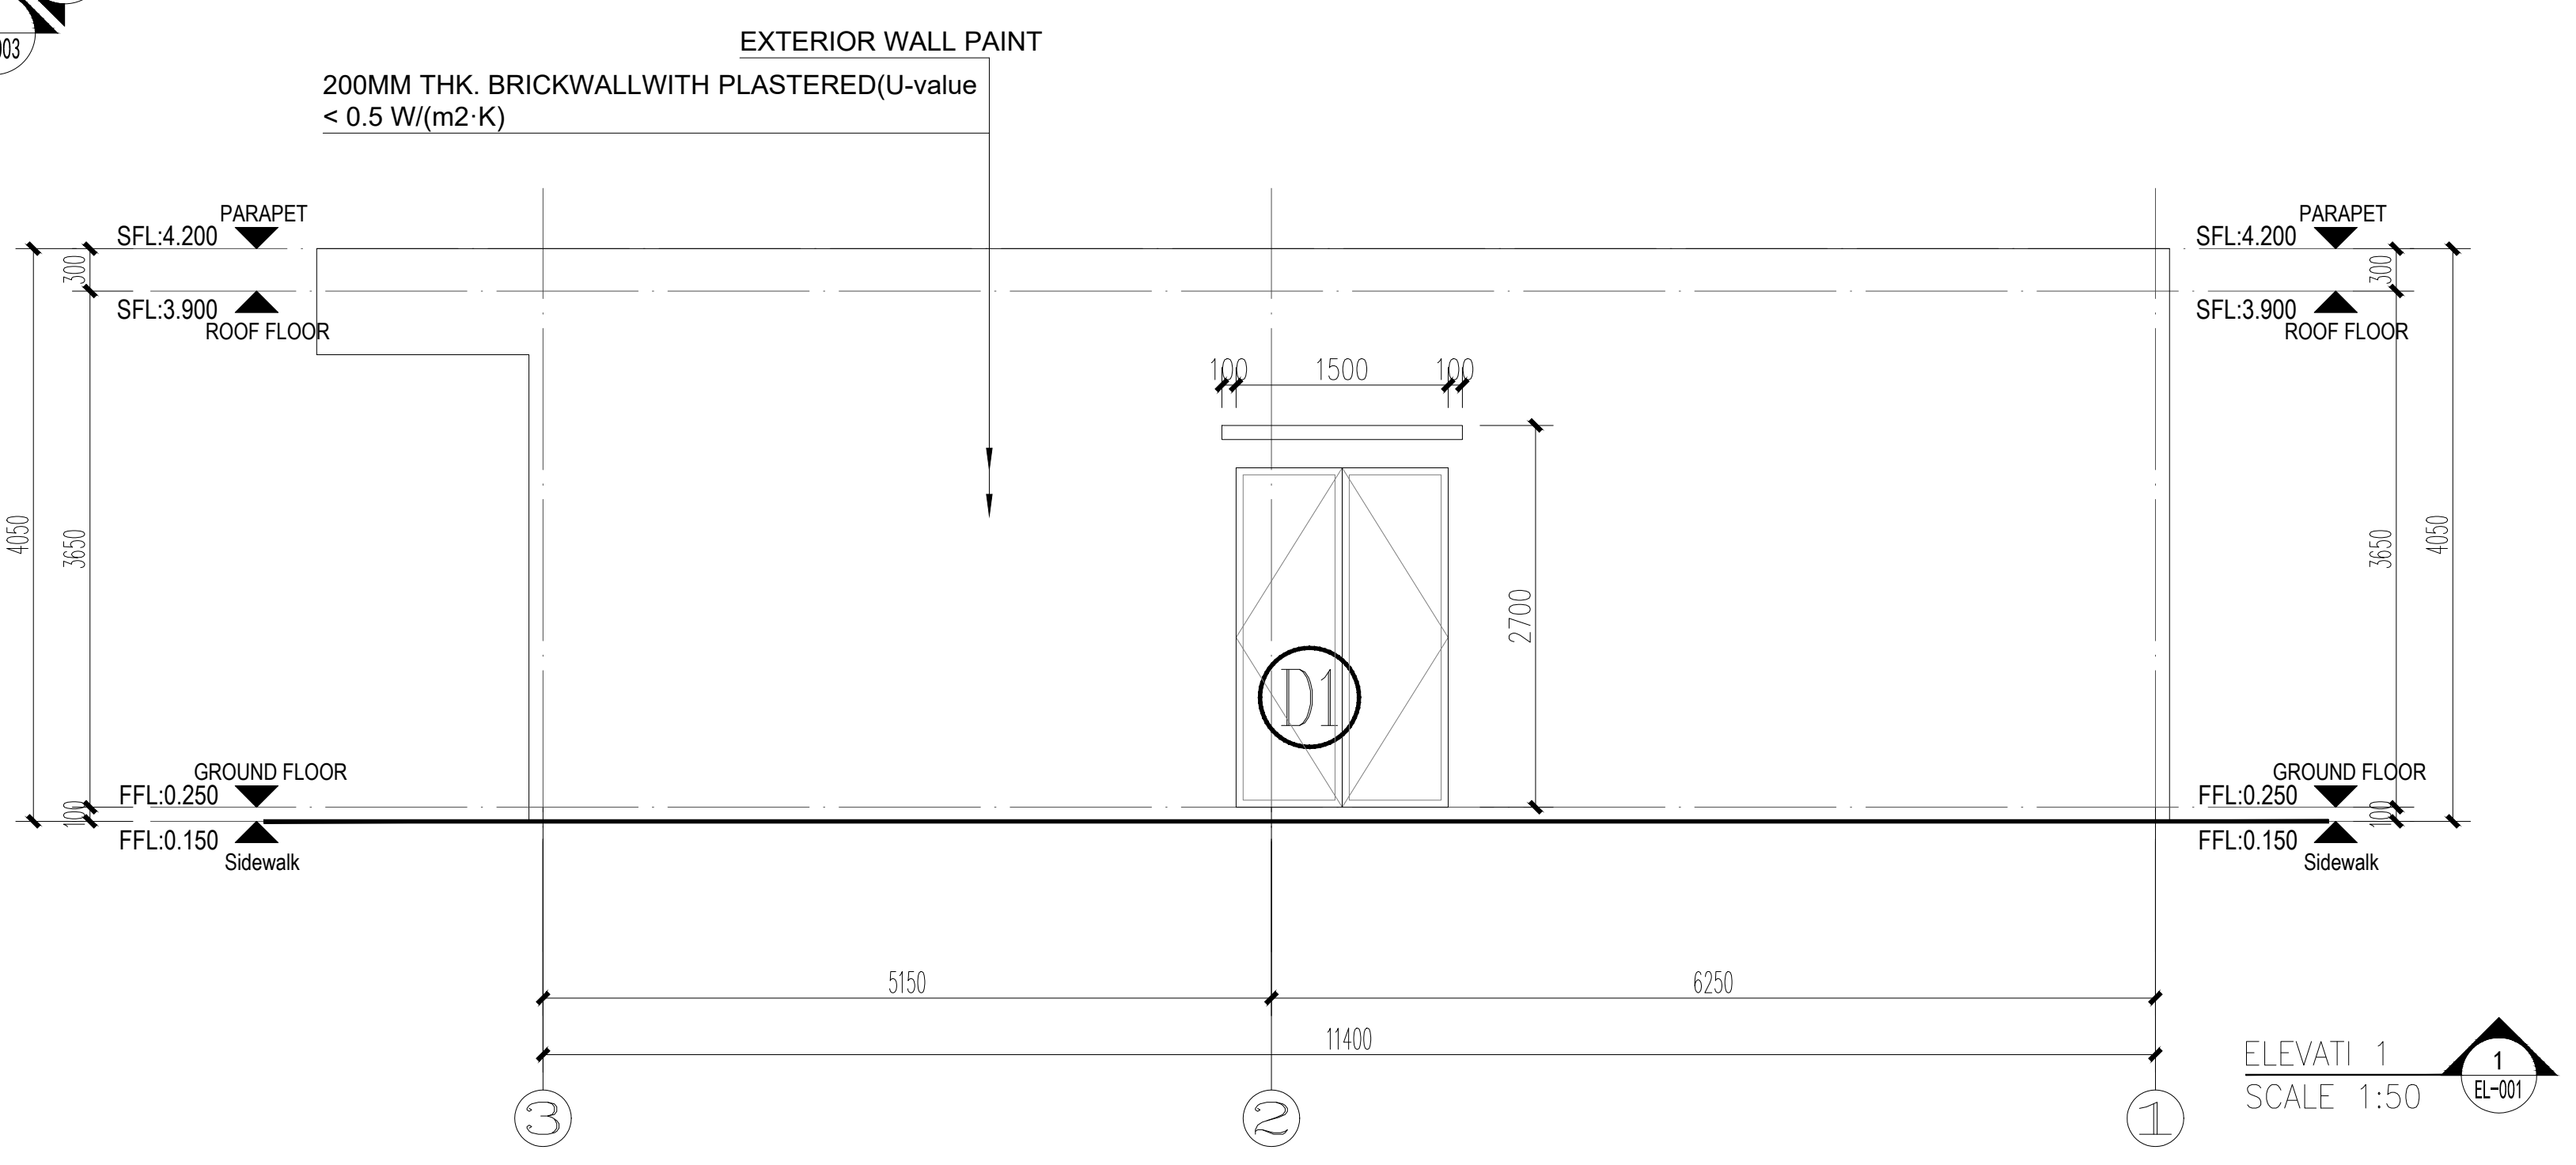

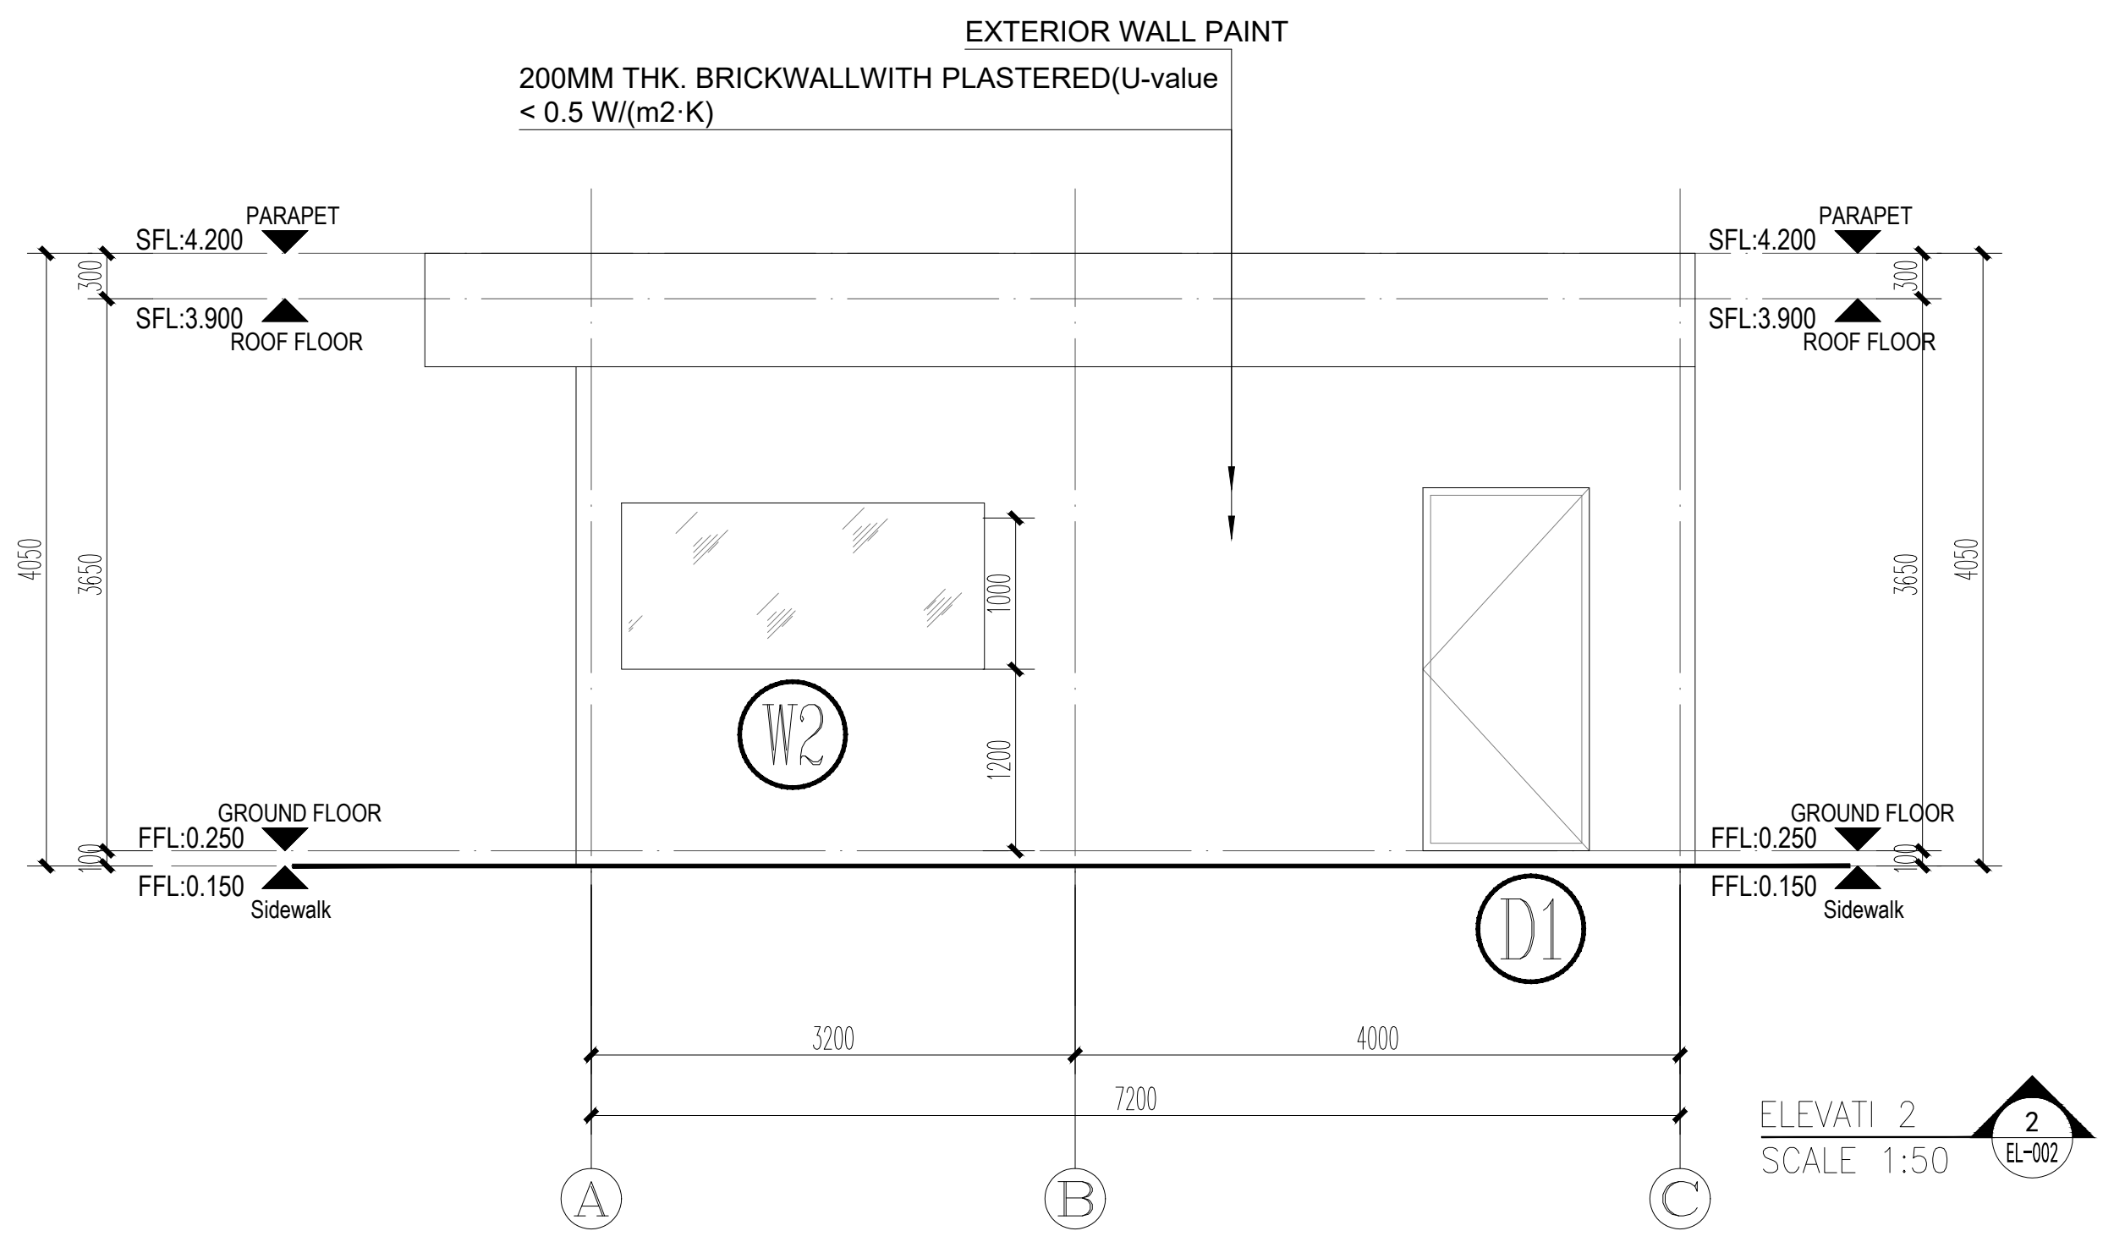

CLIENT :
GULF EDGE DC 01
87 Wireless Road, M Thai Tower 11th. Floor, All Seasons Place, Lumpini,
Pathumwan, Bangkok 10330, Thailand

CONTRACTOR :
华西发展(泰国)有限公司
บริษัท หัวซือ ดีเวลลอปเม้นต์ (ประเทศไทย) จำกัด
HUASHI DEVELOPMENT CO.,LTD
No. 202, Room No. 1403, 14/F, Le Concorde Building,
Ratchadapisek Road, Huaykhwang Sub-District,
Huaykhwang District, Bangkok Metropolitan 10310.

CONSULTANT :
ARbay
บริษัท เอ อาร์ เบย์ จำกัด
ARbay Company Limited
31 st Floor Bangkok Insurance Building
25 South Sathorn road Thungmahamek
Sathorn Bangkok 10120 THAILAND
T +66 (0) 2286 8199
F +66 (0) 2286 2863
info@arbay.co.th

CONSULTANT :
Qbic Engineers & Architects Co.,Ltd.
8 Soi KALONG 4 SANAMBINNAM ROAD,
THASAI SUB-DISTRICT, MUANG NONTHABURI DISTRICT
, NONTHABURI.
Tel 662-950-4374
Fax 662-580-3231
E-Mail : qbic@qbic.co.th, www.qbic.co.th
QBIC ENGINEERS AND ARCHITECTS CO.,LTD.

CONSULTANT :
MITR
MITR TECHNICAL CONSULTANT CO.,LTD.
1168/8 12th FLOOR, LUMPINI TOWER BUILDING,
RAMA IV RD., THUNGMAHAMEK, SATHORN, BANGKOK 10120, THAILAND
TEL : 0-2679-9079-84
FAX : 0-2679-9085 E-mail: mitr_dd@mitr.com

Architect :	SIGNATURE
ประกิต พนานุรัตน์ วสถ. 580 ที่อยู่ 251/1 ถ.จารุเมือง แขวงรองเมือง เขตปทุมวัน กรุงเทพมหานคร โทรศัพท์ 02-286-8199	
Structural Engineer :	SIGNATURE
วิศวกรผู้ออกแบบโครงสร้าง	
ณัฐสม สงวนวงษ์ วย 1423 ที่อยู่ 2/1 ซ.รามคำแหง 150 ถ.รามคำแหง แขวง สะพานสูง เขต สะพานสูง กทม. 10240	ณัฐสม สงวนวงษ์
Structural Inspector :	SIGNATURE
วิศวกรผู้ตรวจสอบโครงสร้าง	
โกมล จุฑาภัทร วย 964 ที่อยู่ 24/18 ซ.นวมินทร์ 129 ถ. นวมินทร์ แขวง นวลจันทร์ เขต บึงกุ่ม กทม. 10230	
Electrical Engineer :	SIGNATURE
วิศวกรผู้ออกแบบระบบไฟฟ้ากำลัง	
นายสุภัทร บูรณวิทย์ วฟก.1265 ที่อยู่ 21 ซอยทานสัมฤทธิ์ 13 ตำบลท่าทราย อ.เมืองนนทบุรี จ.นนทบุรี 11000	
Mechanical Engineer :	SIGNATURE
วิศวกรผู้ออกแบบระบบเครื่องกลและปรับอากาศ	
นายประสิทธิ์ เกียรติสุนทร วก.1221 ที่อยู่ 44/372 ซอยบางกระดี่ 35/1 แขวงแสมดำ เขตบางขุนเทียน กทม. 10150	ประสิทธิ์
Sanitary Engineer :	SIGNATURE
วิศวกรผู้ออกแบบระบบสุขาภิบาล และดับเพลิง	
นายทศวรรษ สนั่นฤทธิ์ วส. 215 ที่อยู่ บ้านเลขที่ 99/107 หมู่ที่ 3 ต.ศีรษะจรเข้น้อย อ.บางเสาธง จ.สมุทรปราการ 10540	ทศวรรษ

ISSUE/REVISION

REV.	DESCRIPTION	DATE
A	90% DEVELOPED	09/05/2026

PROJECT NAME :
GEDC 01
LOCATION:
Nikhom Phattana district, Rayong ,industrial estate,CPGC

BUILDING :
GUARD HOUSE A

90% DEVELOPED

TITLE :
GUARD HOUSE A PLAN & SECTION & ELEVATION

JOB NO.	SCALE 1:50
DRAWN LK	REF.
CHECKED LJC	DWG.NO.
APPROVED LXD	MPK04-60-A-P&EL&SE-101
DATE 2026.05.09	

NOTE : THIS PRINT IS OF A CONFIDENTIAL NATURE, IT SHALL NOT BE TRACED,PHOTOGRAPHED,PHOTOSTATED OR REPRODUCED IN ANY MANER,NOR USED FOR ANY PURPOSE WHATSOEVER EXCEPT BY WRITTEN PERMISSION