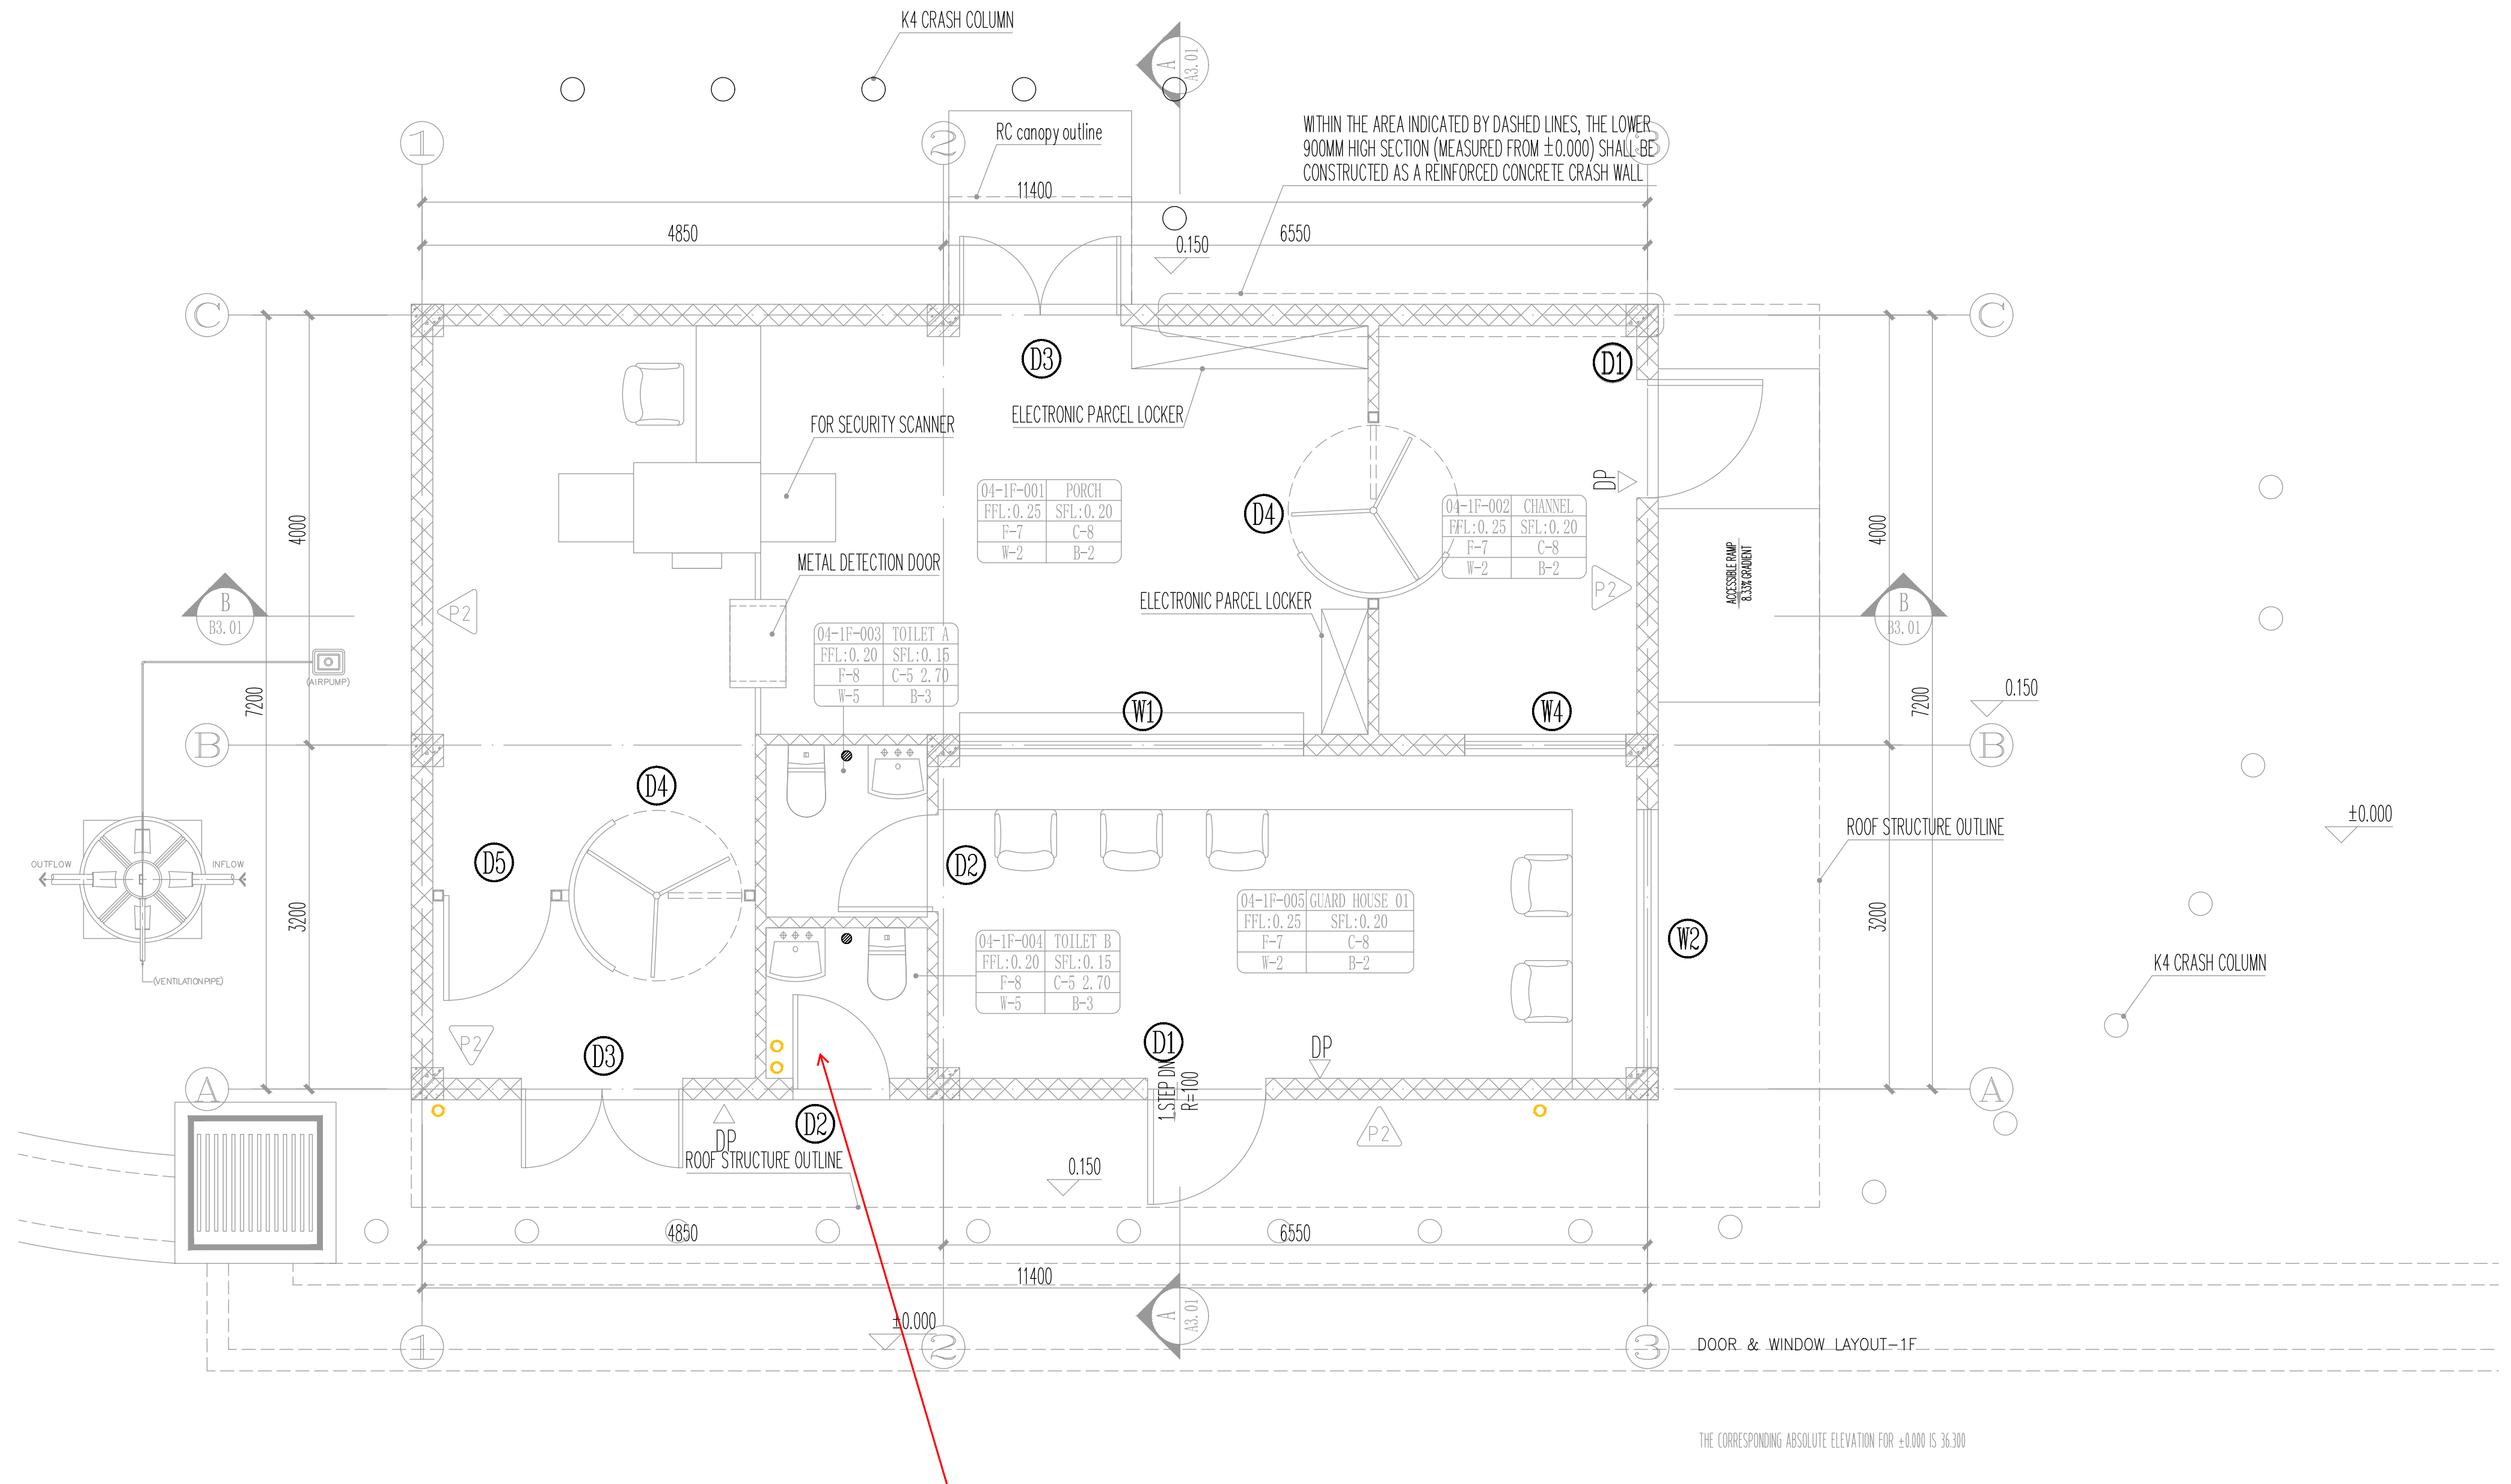
K4 CRASH COLUMN
RC canopy outline
WITHIN THE AREA INDICATED BY DASHED LINES, THE LOWER 900MM HIGH SECTION (MEASURED FROM ±0.000) SHALL BE CONSTRUCTED AS A REINFORCED CONCRETE CRASH WALL
11400
4850
6550
0.150
FOR SECURITY SCANNER
ELECTRONIC PARCEL LOCKER
METAL DETECTION DOOR
D1
D2
D3
D4
D5
W1
W2
W4
DP
04-1F-001 PORCH FFL:0.25 SFL:0.20 F-7 C-8 W-2 B-2
04-1F-002 CHANNEL FFL:0.25 SFL:0.20 F-7 C-8 W-2 B-2
04-1F-003 TOILET A FFL:0.20 SFL:0.15 F-8 C-5 2.70 W-5 B-3
04-1F-004 TOILET B FFL:0.20 SFL:0.15 F-8 C-5 2.70 W-5 B-3
04-1F-005 GUARD HOUSE 01 FFL:0.25 SFL:0.20 F-7 C-8 W-2 B-2
ROOF STRUCTURE OUTLINE
1 STEP DN R=100
±0.000
4000
7200
3200
A
B
C
1
2
3
DOOR & WINDOW LAYOUT-1F
THE CORRESPONDING ABSOLUTE ELEVATION FOR ±0.000 IS 36.300

Modified according to the review comments (ACM_GSA03_DesignReview_SD60_Rev B - Arch)

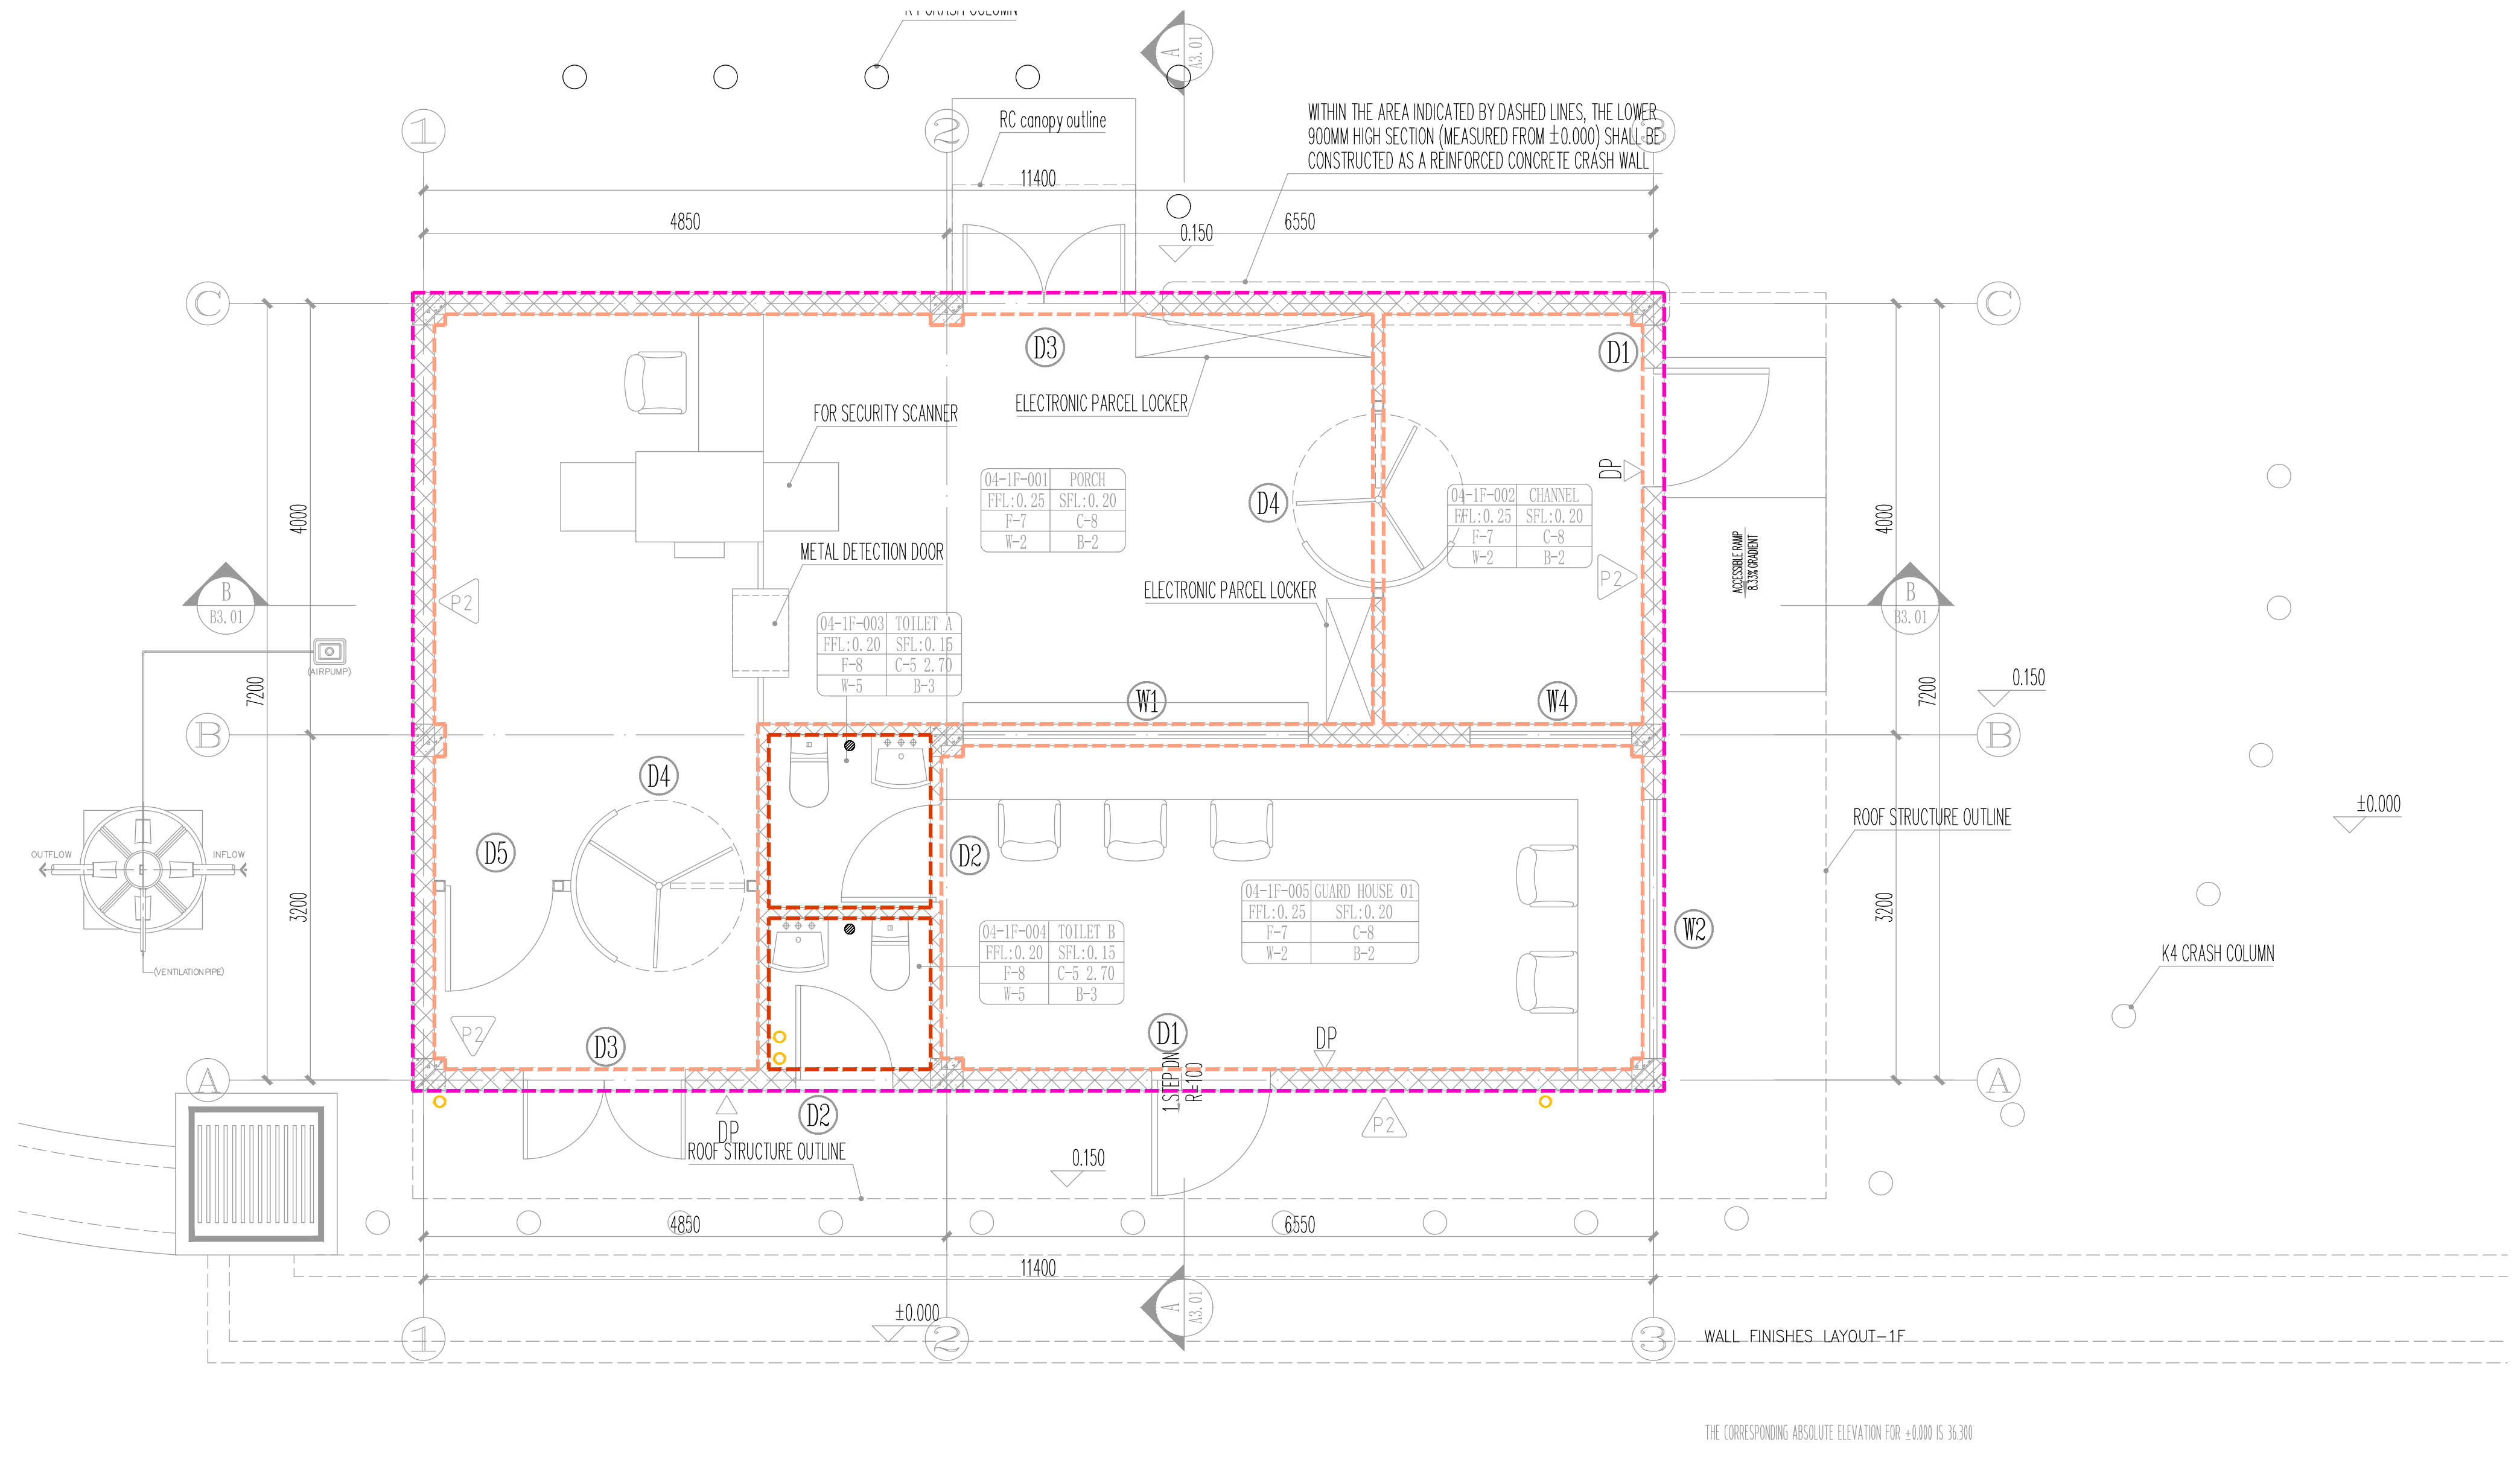
K4 CRASH COLUMN
RC canopy outline
WITHIN THE AREA INDICATED BY DASHED LINES, THE LOWER 900MM HIGH SECTION (MEASURED FROM ±0.000) SHALL BE CONSTRUCTED AS A REINFORCED CONCRETE CRASH WALL
11400
4850
6550
0.150
FOR SECURITY SCANNER
ELECTRONIC PARCEL LOCKER
METAL DETECTION DOOR
D1
D2
D3
D4
D5
W1
W2
W4
DP
ROOF STRUCTURE OUTLINE
±0.000
WALL FINISHES LAYOUT-1F
THE CORRESPONDING ABSOLUTE ELEVATION FOR ±0.000 IS 36.300

DOOR SCHEDULE

	DESCRIPTION	SISE(MM) WIDTH X HEIGHT
D1	G.I METAL FRAME SINGLE LEAF SOLID STEEL DOOR PANEL	1100 X 2400
D2	METAL FRAME WATER RESISTANT TMBERFLUSH DOOR TO MANUF'S DETAIL	900 X 2200
D3	G.I METAL FRAME SINGLE LEAF SOLID STEEL DOOR PANEL SHALL MEET BULLETPROOF REQUIREMENTS	1500 X 2400
D4	S/S FRAME WTH S/S REVOLVING DOOR TO MANUF'SDETAIL AND ARCH'S APPROVAL	1700 X 2400
D5	S/S FRAME WITH S/S SWING DOOR TO MANUF'S DETAIL AND ARCH'S APPROVAL	1050 X 2400
W1	FORCED-ENTRY CLASS WNDOW TO MANUF'SDETAIL(BULLET PROOF GLASS)	3200 X 1100
W2	FORCED-ENTRY CLASS WNDOW TO MANUF'SDETAIL(BULLET PROOF GLASS)	2400 X 1100
W4	FORCED-ENTRY CLASS WNDOW TO MANUF'SDETAIL(BULLET PROOF GLASS)	1500 X 1100

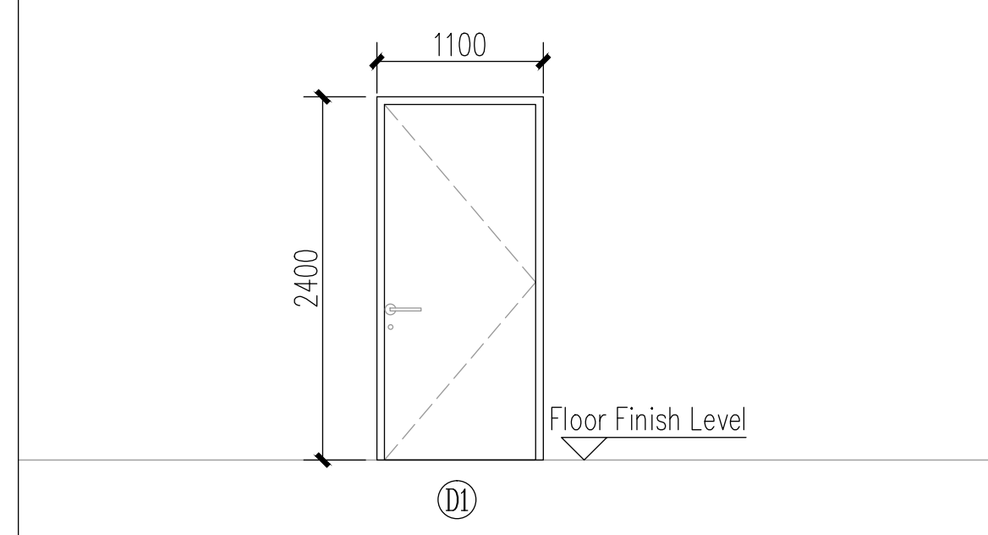

FUNCTON	GUARD HOUSE 01、CHANNEL
TYPE	STEEL SINGLE DOOR,
	SINGLE SWING
HARDWARE	DOOR CLOSER
	DOOR STOPPER
	HANDLE
	KEY
Total	2

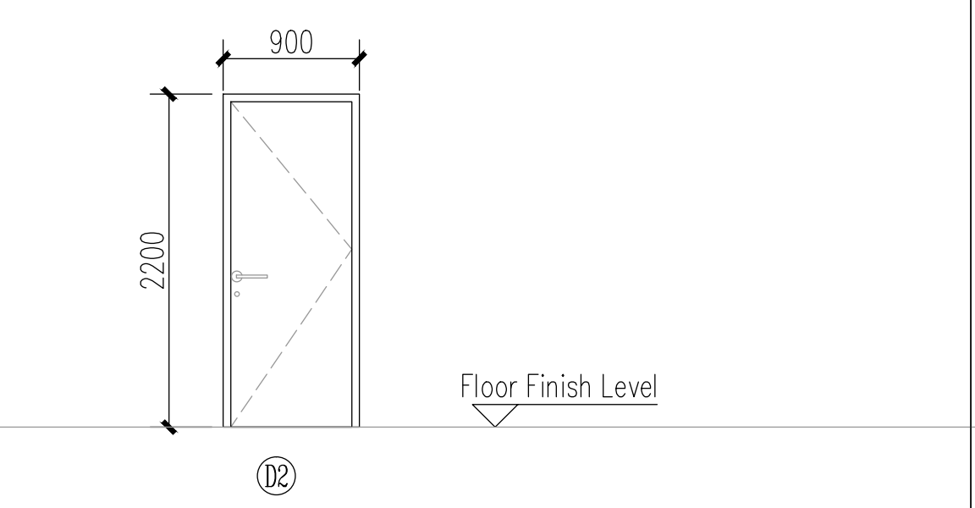

FUNCTON	TOILET A、TOILET B
TYPE	METAL FRAME WATER RESISTANT TMBERFLUSH DOOR
	SINGLE SWING
HARDWARE	DOOR CLOSER
	DOOR STOPPER
	HANDLE
	KEY
Total	2

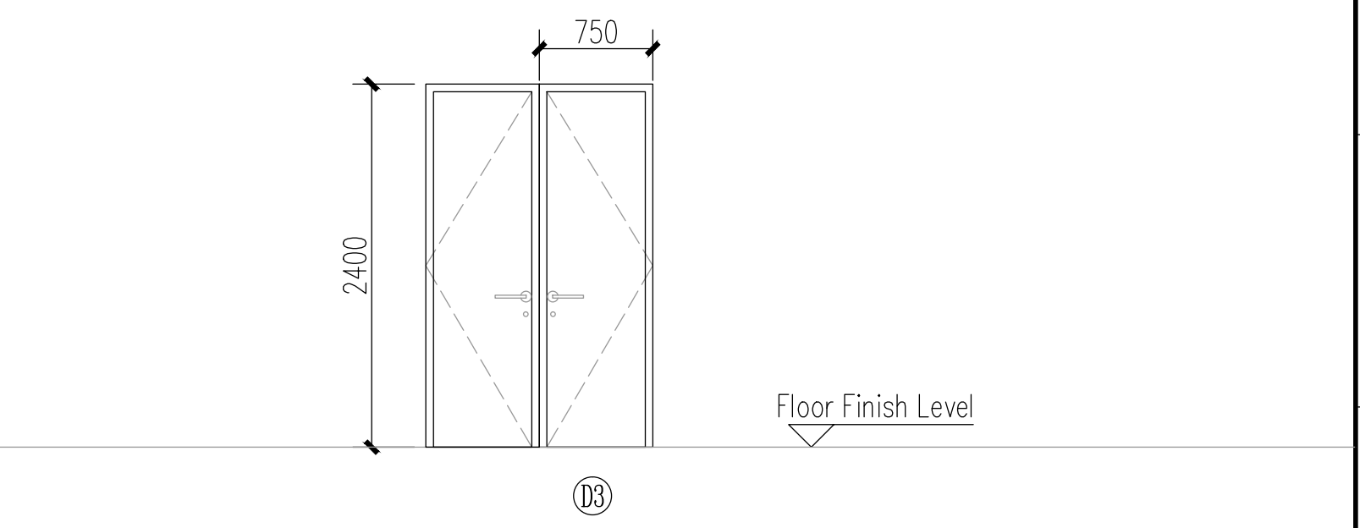

FUNCTON	PORCH
TYPE	G.I METAL FRAME SINGLE LEAF SOLID STEEL DOOR PANEL SHALL MEET BULLETPROOF REQUIREMENTS
	DOUBLE SWING
HARDWARE	DOOR CLOSER
	DOOR STOPPER
	HANDLE
	KEY
Total	2

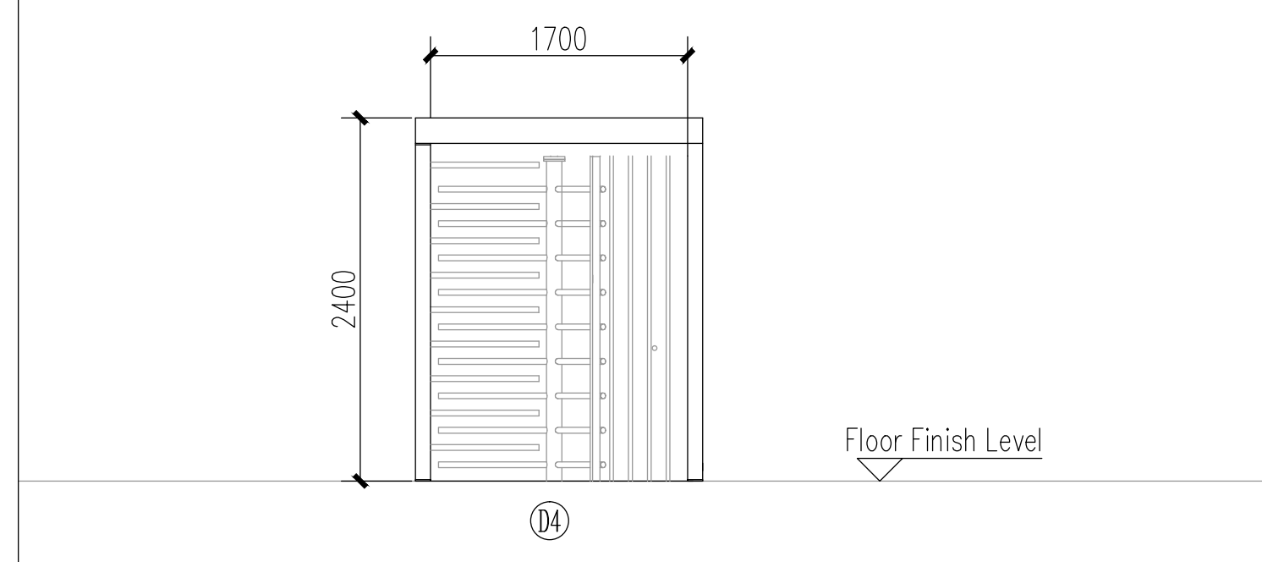

FUNCTON	GUARD HOUSE 01、CHANNEL
TYPE	S/S FRAME WTH S/S REVOLVING DOOR TO MANUF'SDETAIL AND ARCH'S APPROVAL
HARDWARE	
Total	2

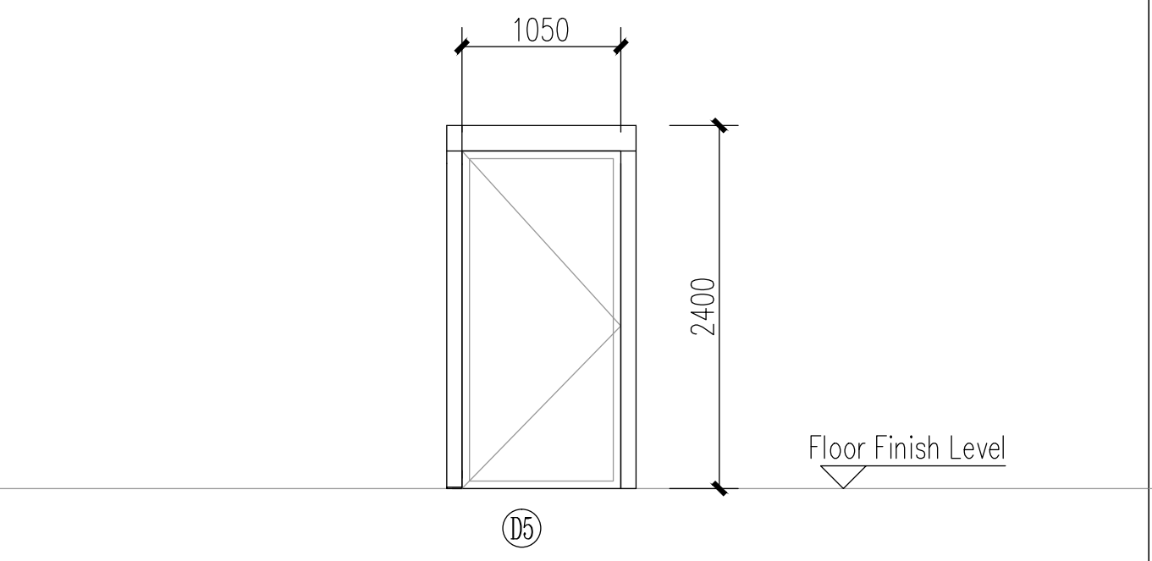

FUNCTON	GUARD HOUSE 01、CHANNEL
TYPE	S/S FRAME WITH S/S SWING DOOR TO MANUF'S DETAIL AND ARCH'S APPROVAL
HARDWARE	
Total	2

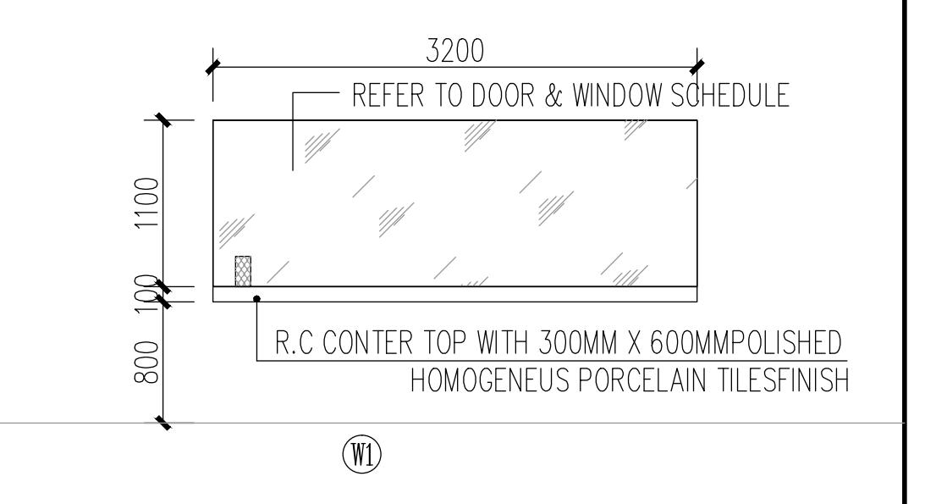
3200
REFER TO DOOR & WINDOW SCHEDULE
1100
100
800
R.C CONTER TOP WITH 300MM X 600MMPOLISHED HOMOGENEUS PORCELAIN TILESFINISH
W1

FUNCTON	GUARD HOUSE 01
TYPE	GALVANIZED STEEL WINDOW(BULLET PROOF GLASS)
HARDWARE	
Total	

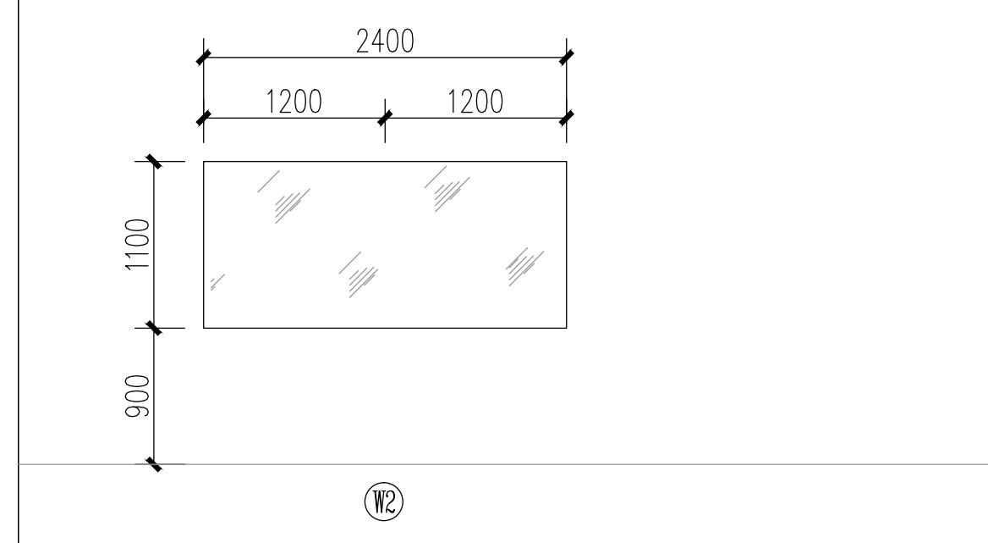

FUNCTON	GUARD HOUSE 01
TYPE	GALVANIZED STEEL WINDOW(BULLET PROOF GLASS)
HARDWARE	
Total	

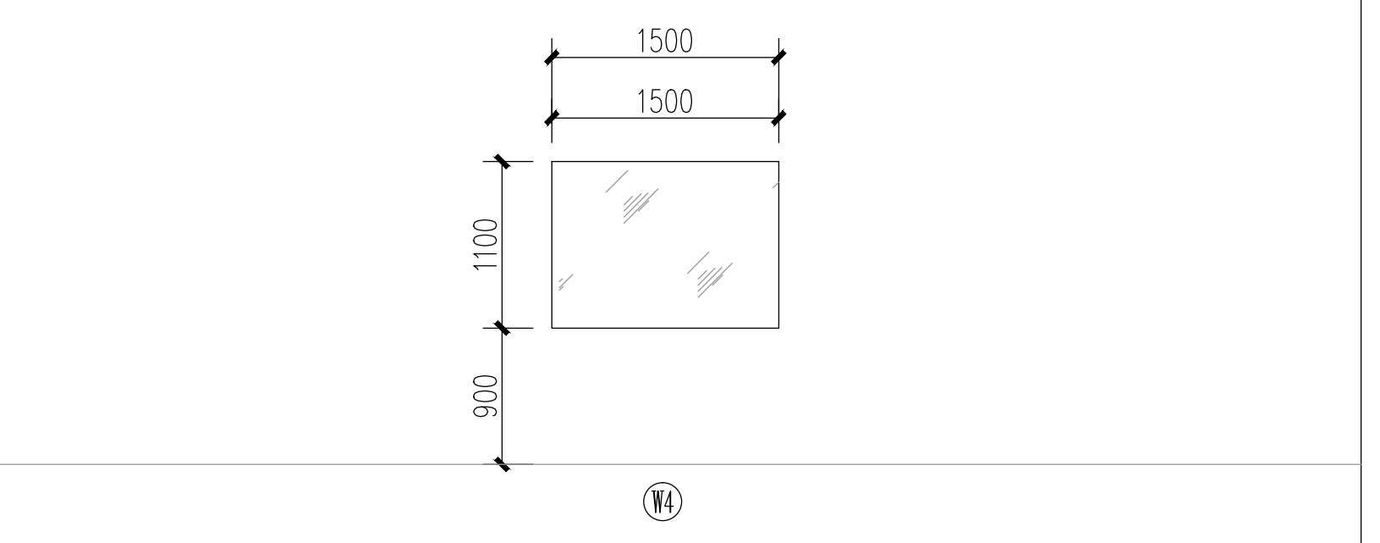

FUNCTON	GUARD HOUSE 01
TYPE	GALVANIZED STEEL WINDOW(BULLET PROOF GLASS)
HARDWARE	
Total	

LEED: Remark for all door & window glazing
Exterior Glazing Performance:
SHGC=0.3 or better
U–value = 2.0 W/(m2K) or better'
Notes:
The specific specifications for doors, windows, and hardware will be provided during the IFC review stage.

LEGEND	Wall No.	Description	TILE SIZE(MM) WIDTH X DEPTH
- - - -	W-2	Skim Coat With Scrub Resistant Paint	Scratch-resistant
- - - -	W-5	12mm Thk Waterproof Homogenous Tile	Waterproof
- - - -	WF-1	EXTERIOR WALL PAINT	

CLIENT :

GULF EDGE DC 01

87 Wireless Road, M Thai Tower 11th. Floor, All Seasons Place, Lumpini,
Pathumwan, Bangkok 10330, Thailand

CONTRACTOR :

华西发展(泰国)有限公司
บริษัท หัวซือ ดีเวลลอปเม้นต์ (ประเทศไทย) จำกัด
HUASHI DEVELOPMENT CO.,LTD
No. 202, Room No. 1403, 14/F, Le Concorde Building,
Ratchadapisek Road, Huaykhwang Sub-District,
Huaykhwang District, Bangkok Metropolitan 10310.

CONSULTANT :

ARbay
บริษัท เอ อาร์ เบย์ จำกัด
ARbay Company Limited
31 st Floor Bangkok Insurance Building
25 South Sathorn road Thungmahamek
Sathorn Bangkok 10120 THAILAND
T +66 (0) 2286 8199
F +66 (0) 2286 2863
info@arbay.co.th

CONSULTANT :

Qbic Engineers & Architects Co.,Ltd.
8 Soi KALONG 4 SANAMBINNAM ROAD,
THASAI SUB-DISTRICT, MUANG NONTHABURI DISTRICT
, NONTHABURI.
Tel 662-950-4374
Fax 662-580-3231
E-Mail : qbic@qbic.co.th, www.qbic.co.th
QBIC ENGINEERS AND ARCHITECTS CO.,LTD.

CONSULTANT :

MITR
MITR TECHNICAL CONSULTANT CO.,LTD.
1168/8 12th FLOOR, LUMPINI TOWER BUILDING,
RAMA IV RD., THUNGMAHAMEK, SATHORN, BANGKOK 10120, THAILAND
TEL : 0-2679-9079-84
FAX : 0-2679-9085 E-mail: mitr_dd@mitr.com

Architect :	SIGNATURE
ประกิต พนานุรัตน์ วสถ. 580 ที่อยู่ 251/1 ถ.จารุเมือง แขวงรองเมือง เขตปทุมวัน กรุงเทพมหานคร โทรศัพท์ 02-286-8199	

Structural Engineer :	SIGNATURE
วิศวกรผู้ออกแบบโครงสร้าง	
ณัฐสม สงวนวงษ์ วย 1423 ที่อยู่ 2/1 ซ.รามคำแหง 150 ถ.รามคำแหง แขวง สะพานสูง เขต สะพานสูง กทม. 10240	

Structural Inspector :	SIGNATURE
วิศวกรผู้ตรวจสอบโครงสร้าง	
โกมล จุฑาภัทร วย 964 ที่อยู่ 24/18 ซ.นวมินทร์ 129 ถ. นวมินทร์ แขวง นวลจันทร์ เขต บึงกุ่ม กทม. 10230	

Electrical Engineer :	SIGNATURE
วิศวกรผู้ออกแบบระบบไฟฟ้ากำลัง	
นายสุภัทร บูรณวิทย์ วฟก.1265 ที่อยู่ 21 ซอยทานสัมฤทธิ์ 13 ตำบลท่าทราย อ.เมืองนนทบุรี จ.นนทบุรี 11000	

Mechanical Engineer :	SIGNATURE
วิศวกรผู้ออกแบบระบบเครื่องกลและปรับอากาศ	
นายประสิทธิ์ เกียวสุนทร วก.1221 ที่อยู่ 44/372 ซอยบางกระดี่ 35/1 แขวงแสมดำ เขตบางขุนเทียน กทม. 10150	ประสิทธิ์

Sanitary Engineer :	SIGNATURE
วิศวกรผู้ออกแบบระบบสุขาภิบาล และดับเพลิง	
นายทศวรรษ สันนฤทธิ์ วส. 215 ที่อยู่ บ้านเลขที่ 99/107 หมู่ที่ 3 ต.ศีรษะจรเข้น้อย อ.บางเสาธง จ.สมุทรปราการ 10540	ทศวรรษ

ISSUE/REVISION

REV.	DESCRIPTION	DATE
A	90% DEVELOPED	09/05/2026

PROJECT NAME :

GEDC 01

LOCATION:
Nikhom Phattana district, Rayong ,industrial estate,CPGC

BUILDING :

GUARD HOUSE A

90% DEVELOPED

TITLE :

DOOR & WINDOW & WALL
FINISHES LAYOUT

JOB NO.	SCALE 1:50
DRAWN LK	REF.
CHECKED LJC	DWG.NO.
APPROVED LXD	MPK04-60-A-DW&WF-101
DATE 2026.05.09	

NOTE : THIS PRINT IS OF A CONFIDENTIAL NATURE, IT SHALL NOT BE TRACED,PHOTOGRAPHED,PHOTOSTATED OR REPRODUCED IN ANY MANER,NOR USED FOR ANY PURPOSE WHATSOEVER EXCEPT BY WRITTEN PERMISSION