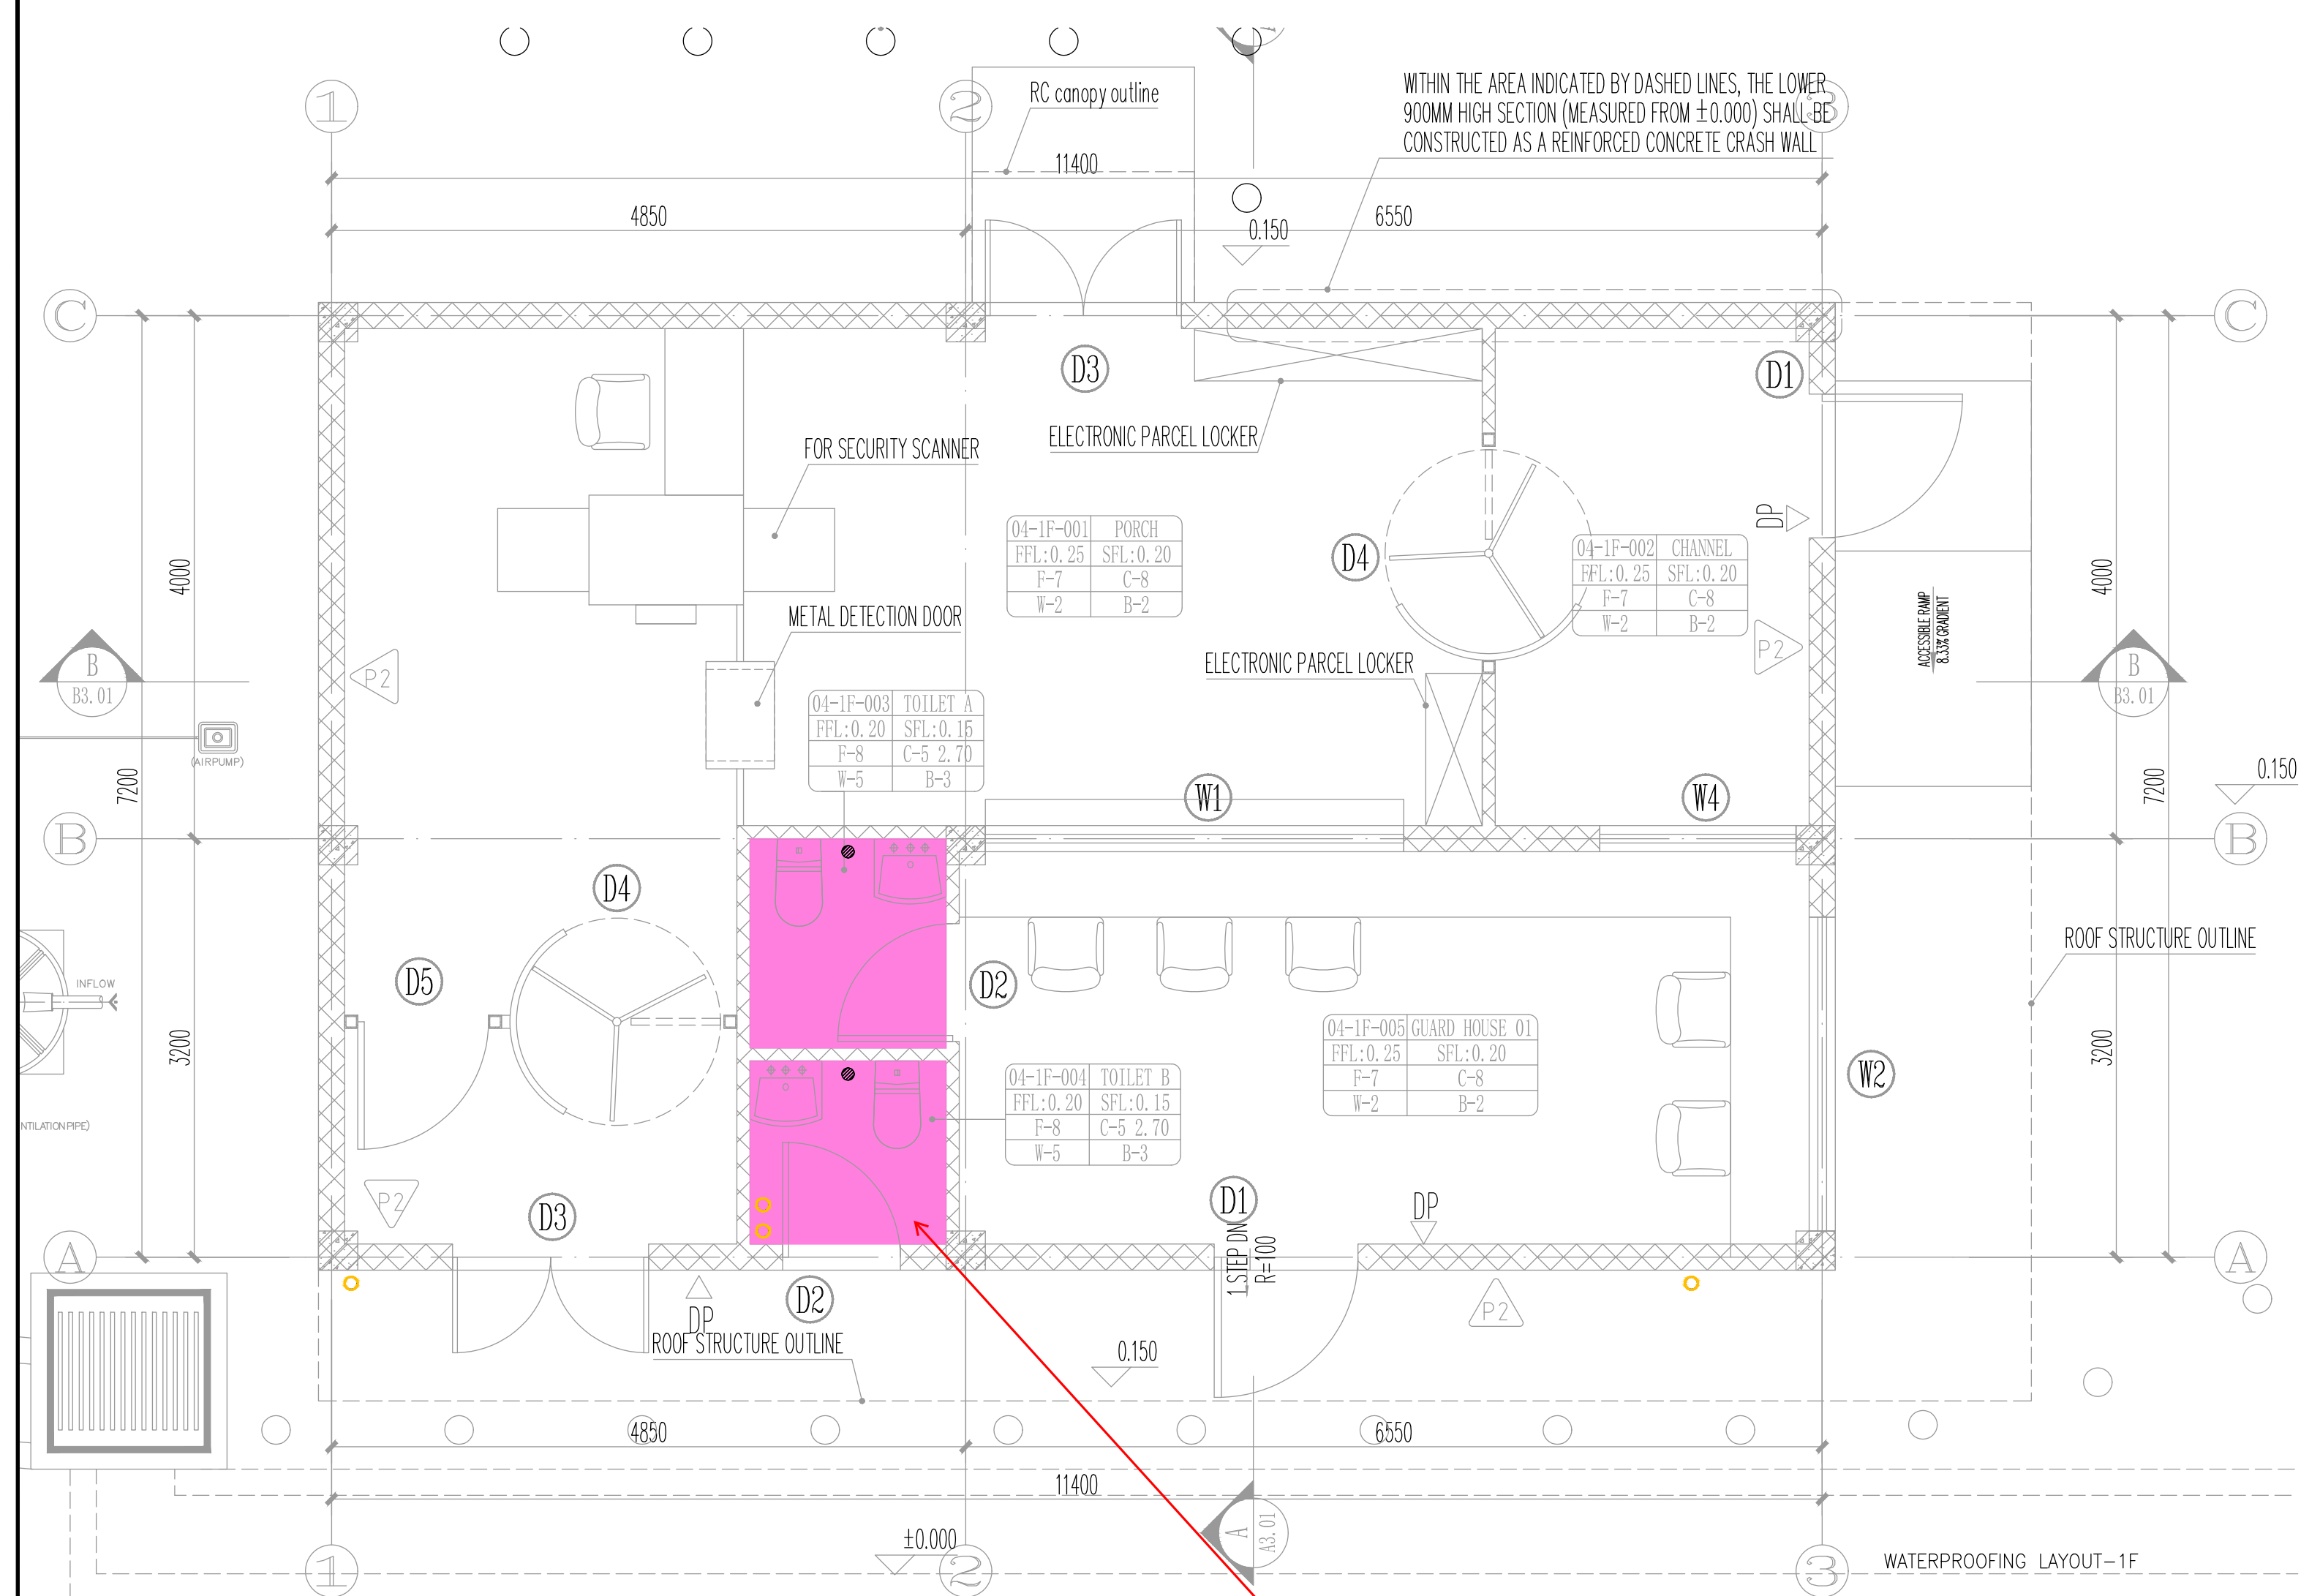

WATERPROOFING LAYOUT-1F

Modified according to the review comments (ACM_GSA03_DesignReview_SD60_Rev B - Arch)

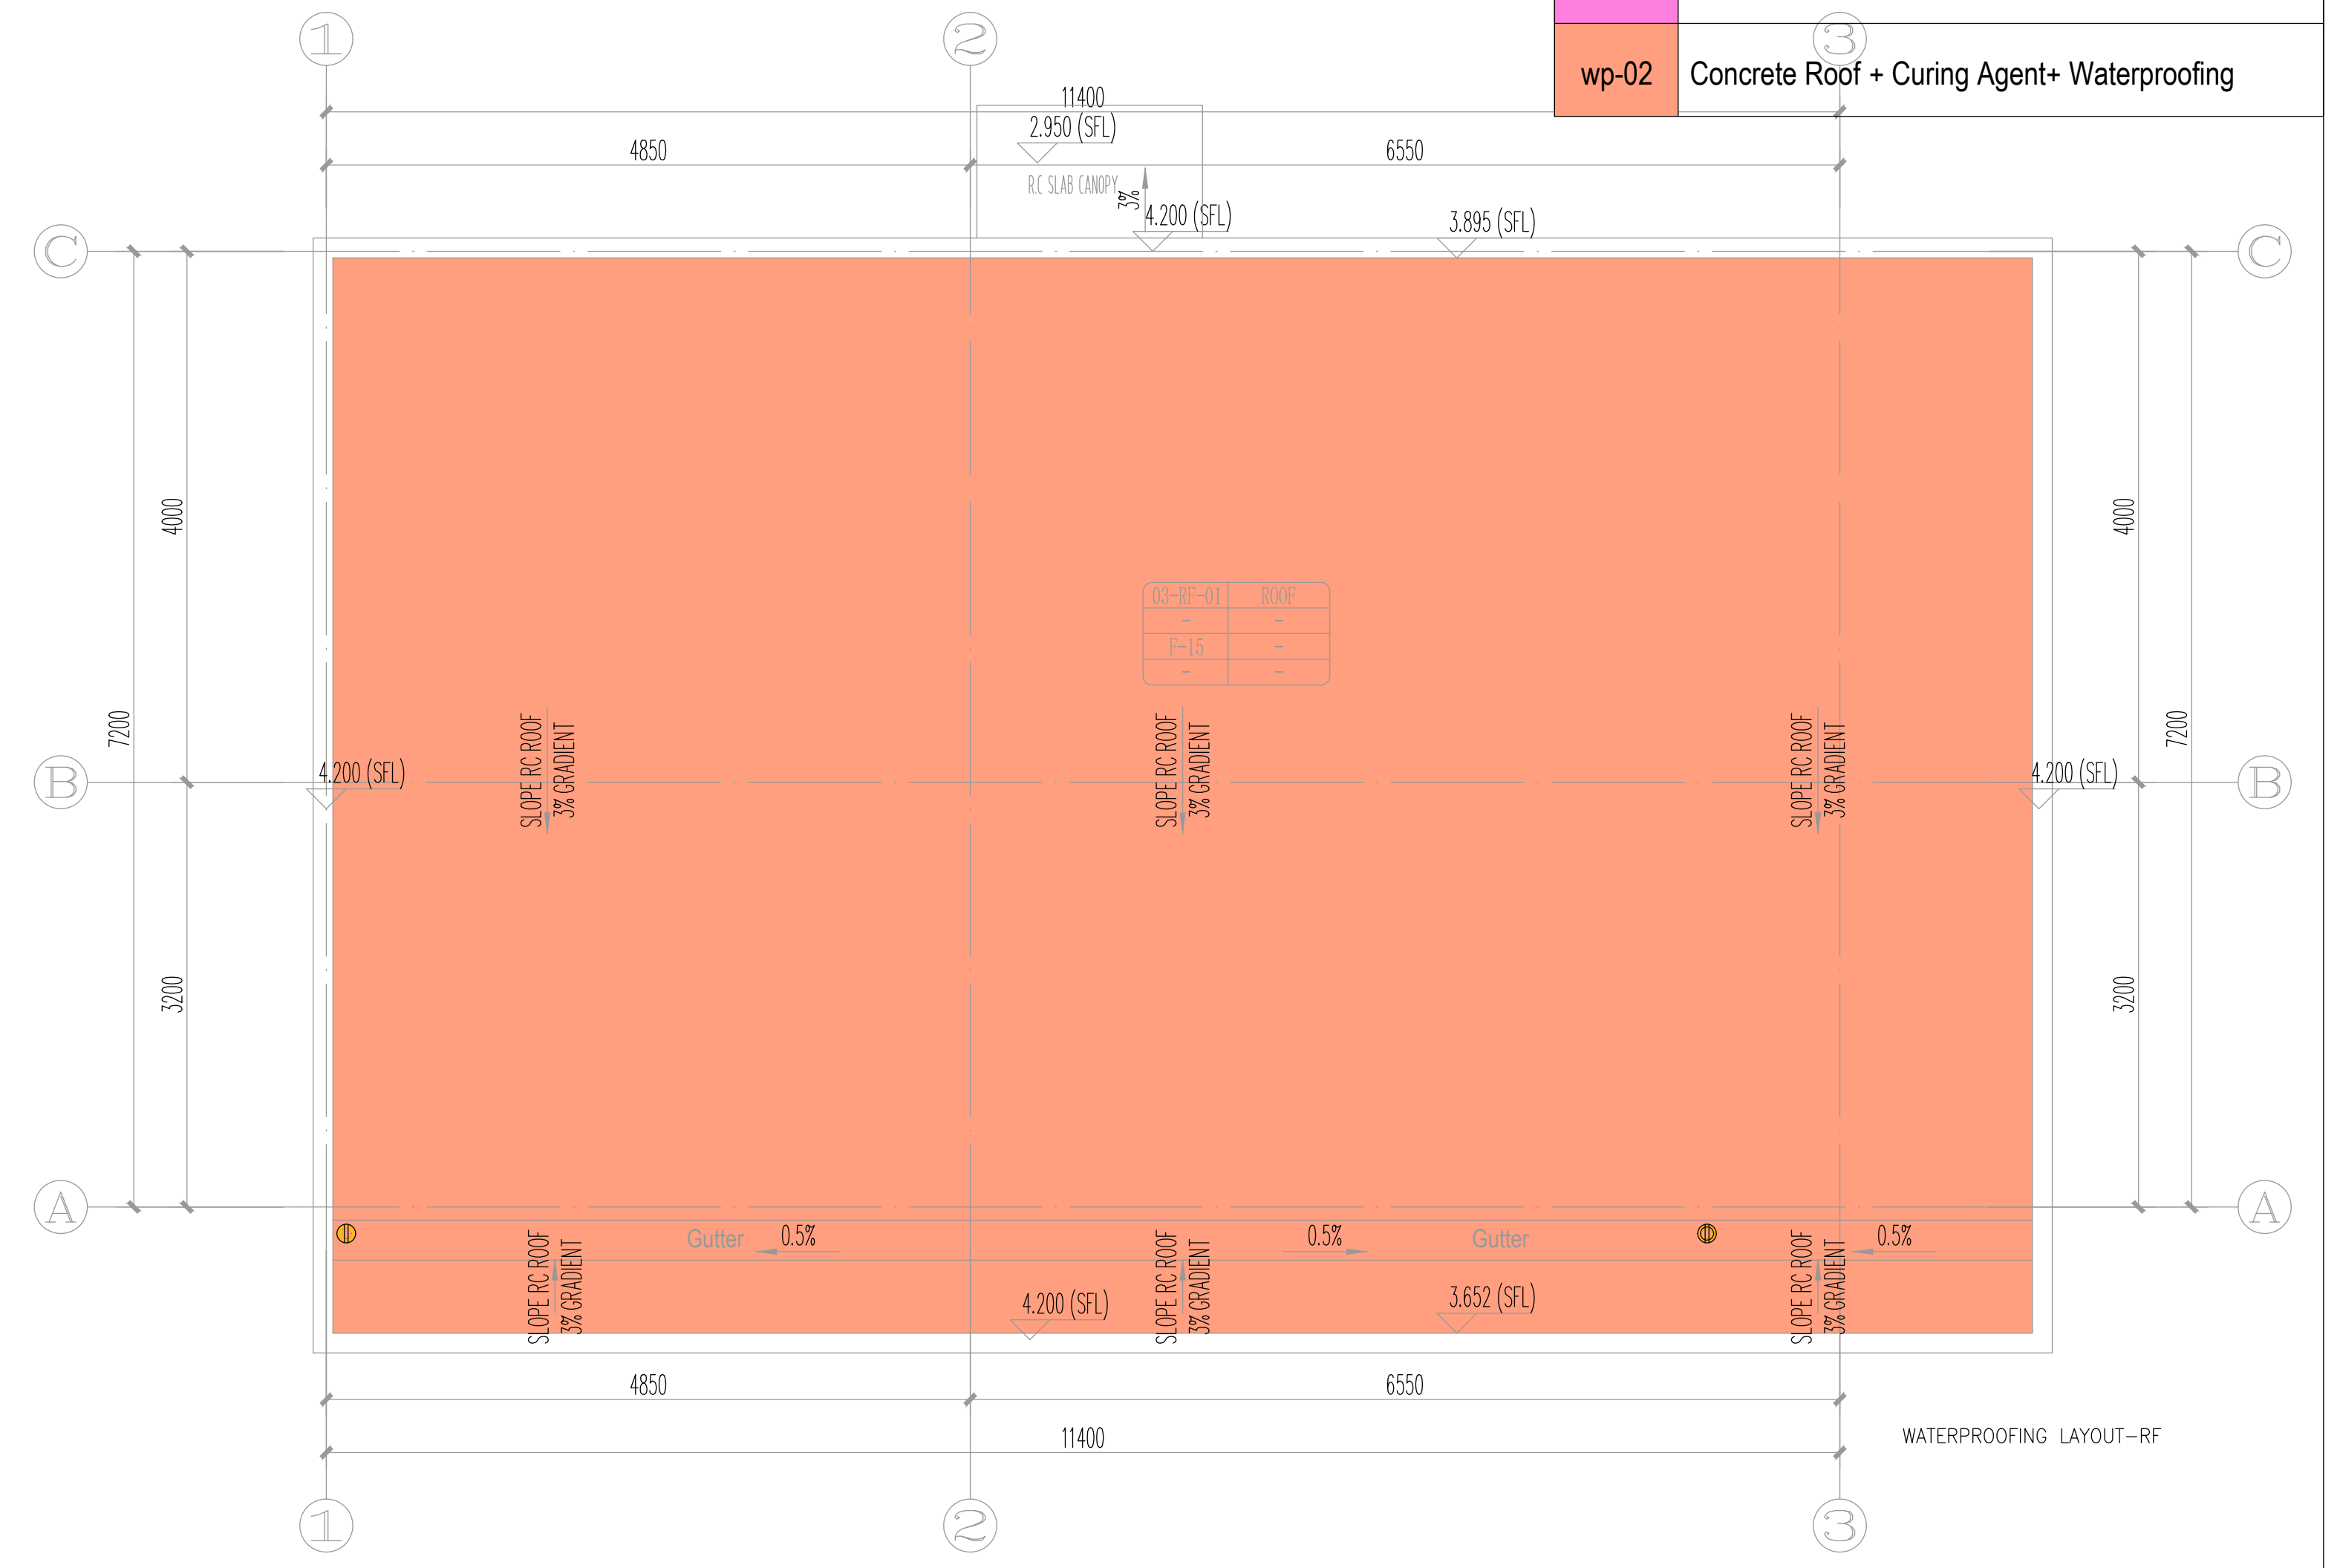

WATERPROOFING LAYOUT-RF

WATER PROOFING	
wp-01	Cementitious waterproofing(to manufacturer's detail)
wp-02	Concrete Roof + Curing Agent+ Waterproofing

Legend	Ceiling No.	Description	Ceiling Material & Finish Specification	Vender
▨	C-3	MOISTURE-PROOF PAINT	MOISTURE-PROOF PAINT ON CONCRETE CEILING SLAB	
▨	C-5	ALUMINIUM BUCKLE PLATE CEILING	MOISTURE PROOF ALUMINIUM BUCKLE PLATE CEILING + ANTI-DUST PAINT SOFFIT	

LEGEND	
YL	100MM HDPE
TL	100MM PVC

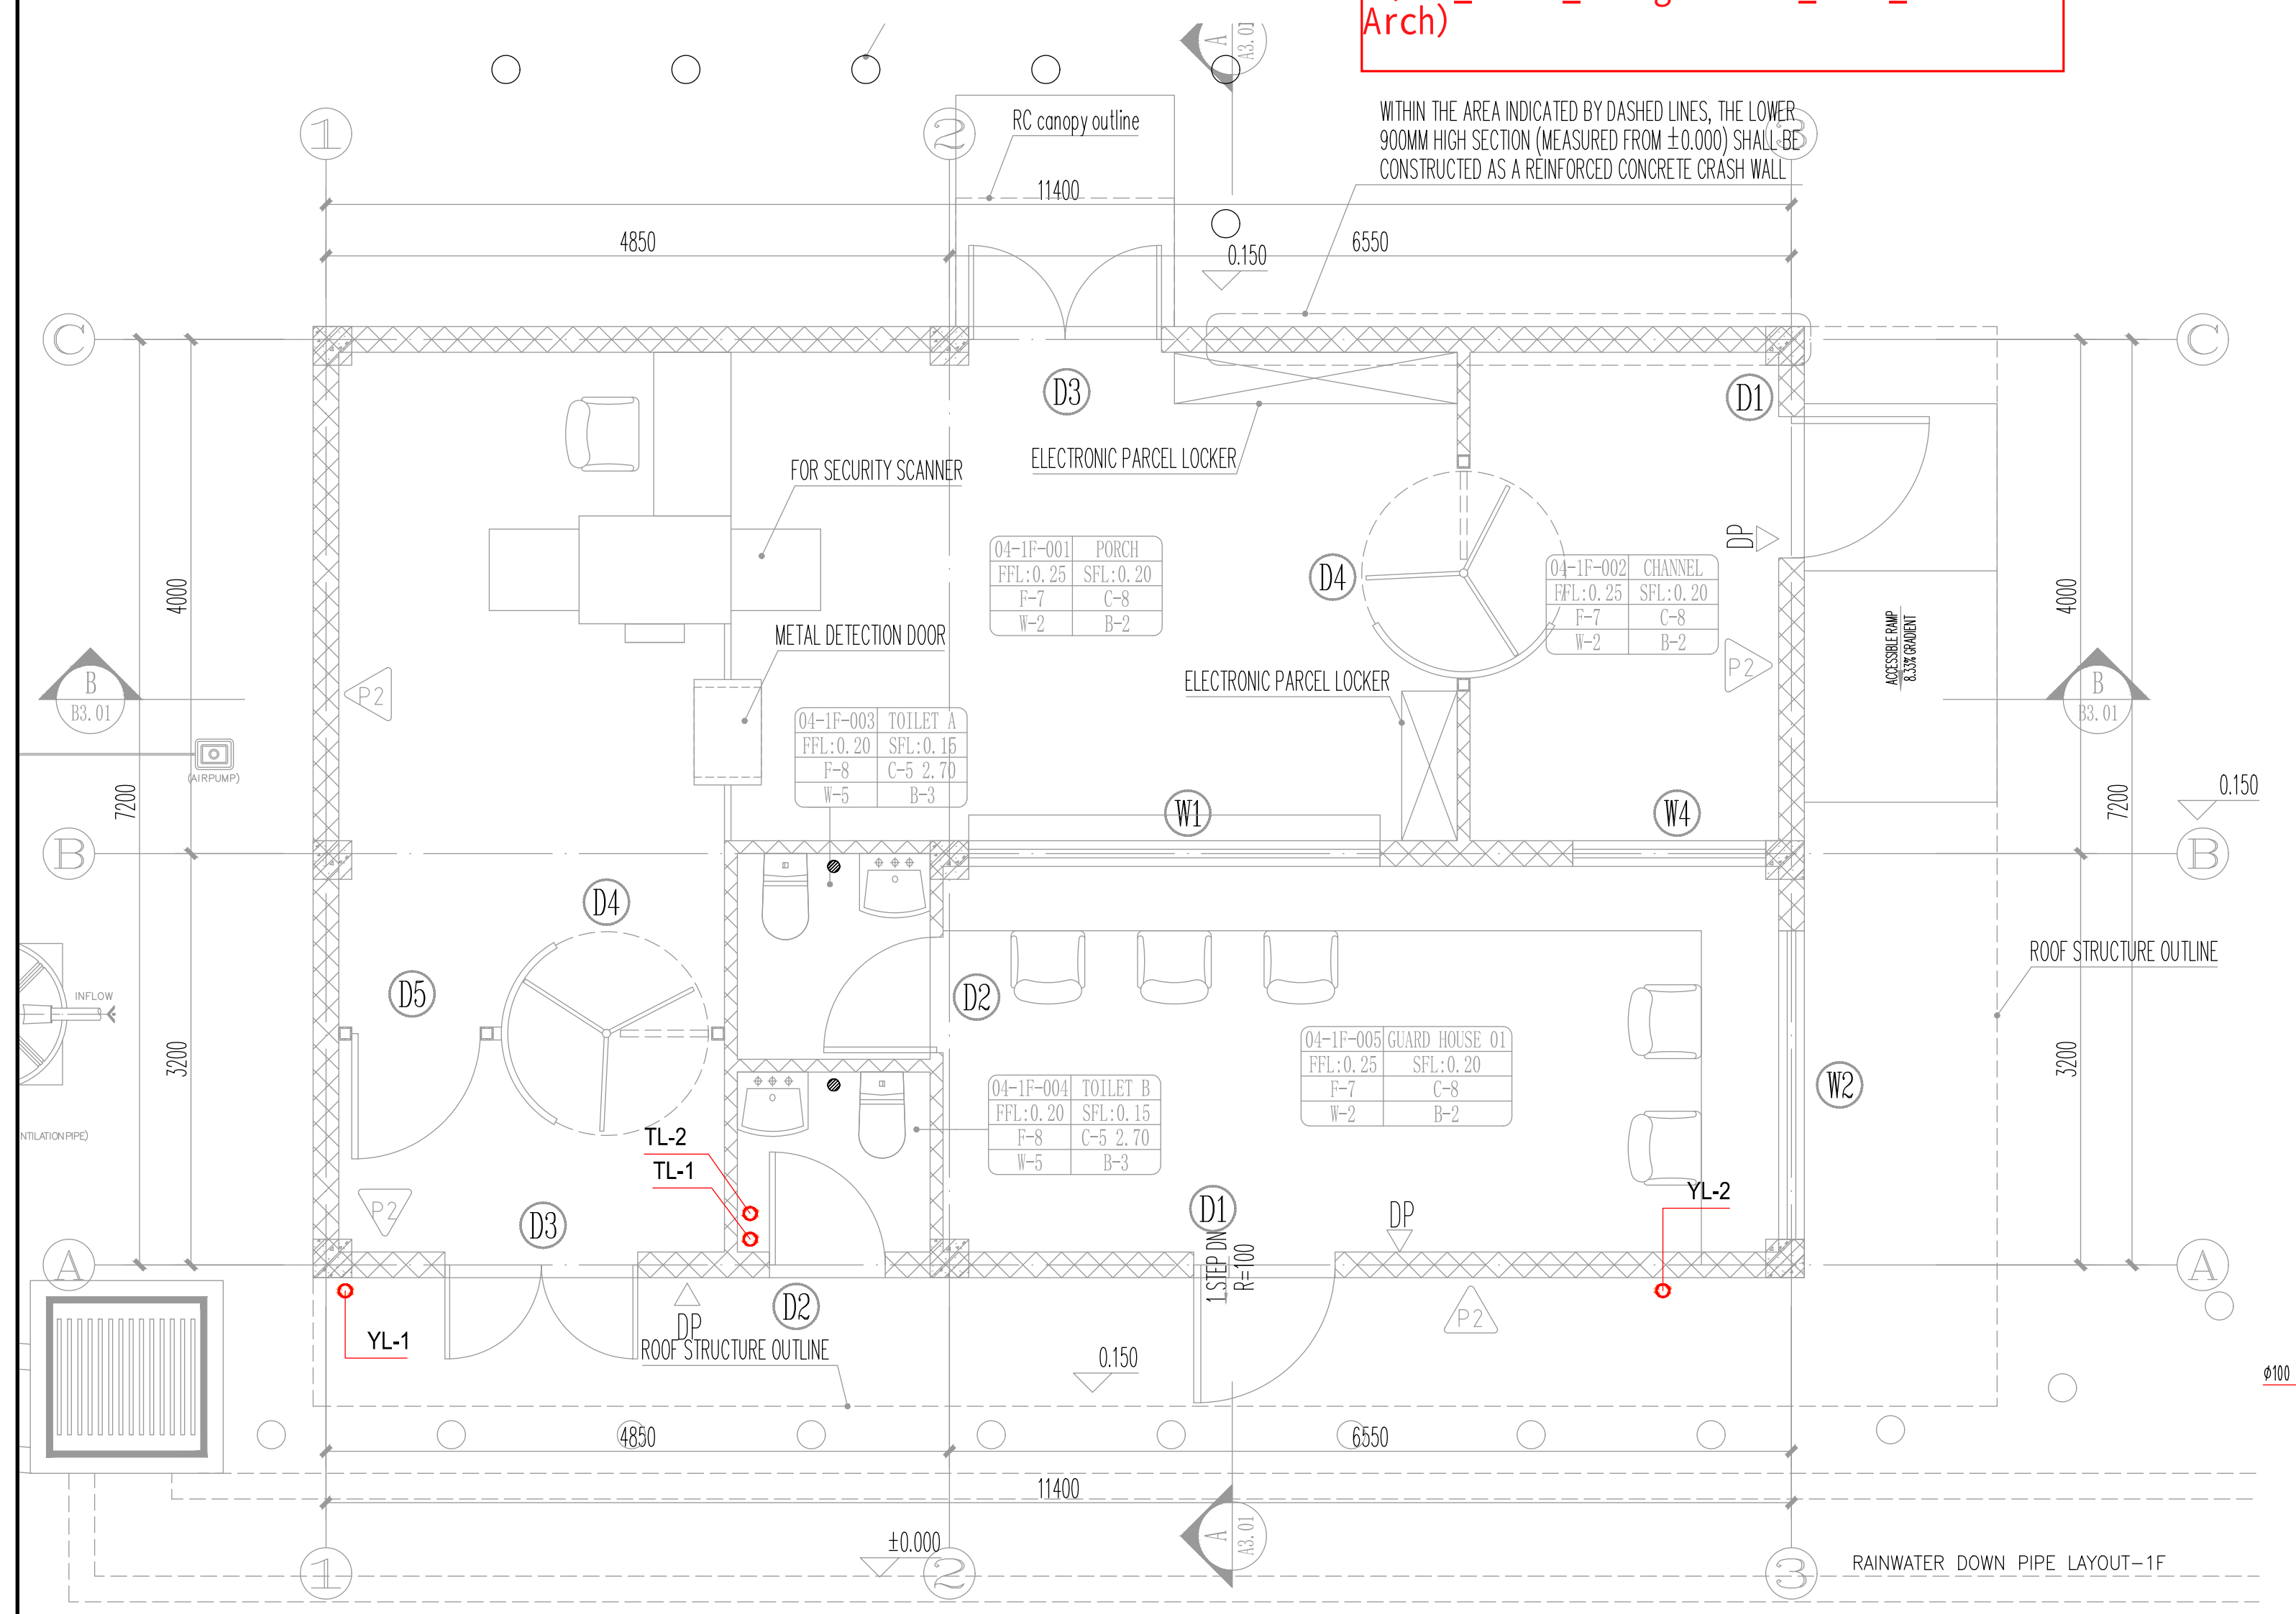
RC canopy outline
11400
4850
6550
0.150
WITHIN THE AREA INDICATED BY DASHED LINES, THE LOWER 900MM HIGH SECTION (MEASURED FROM ±0.000) SHALL BE CONSTRUCTED AS A REINFORCED CONCRETE CRASH WALL
FOR SECURITY SCANNER
ELECTRONIC PARCEL LOCKER
METAL DETECTION DOOR
ROOF STRUCTURE OUTLINE
TL-2
TL-1
YL-1
YL-2
DP
±0.000

RAINWATER DOWN PIPE LAYOUT-1F

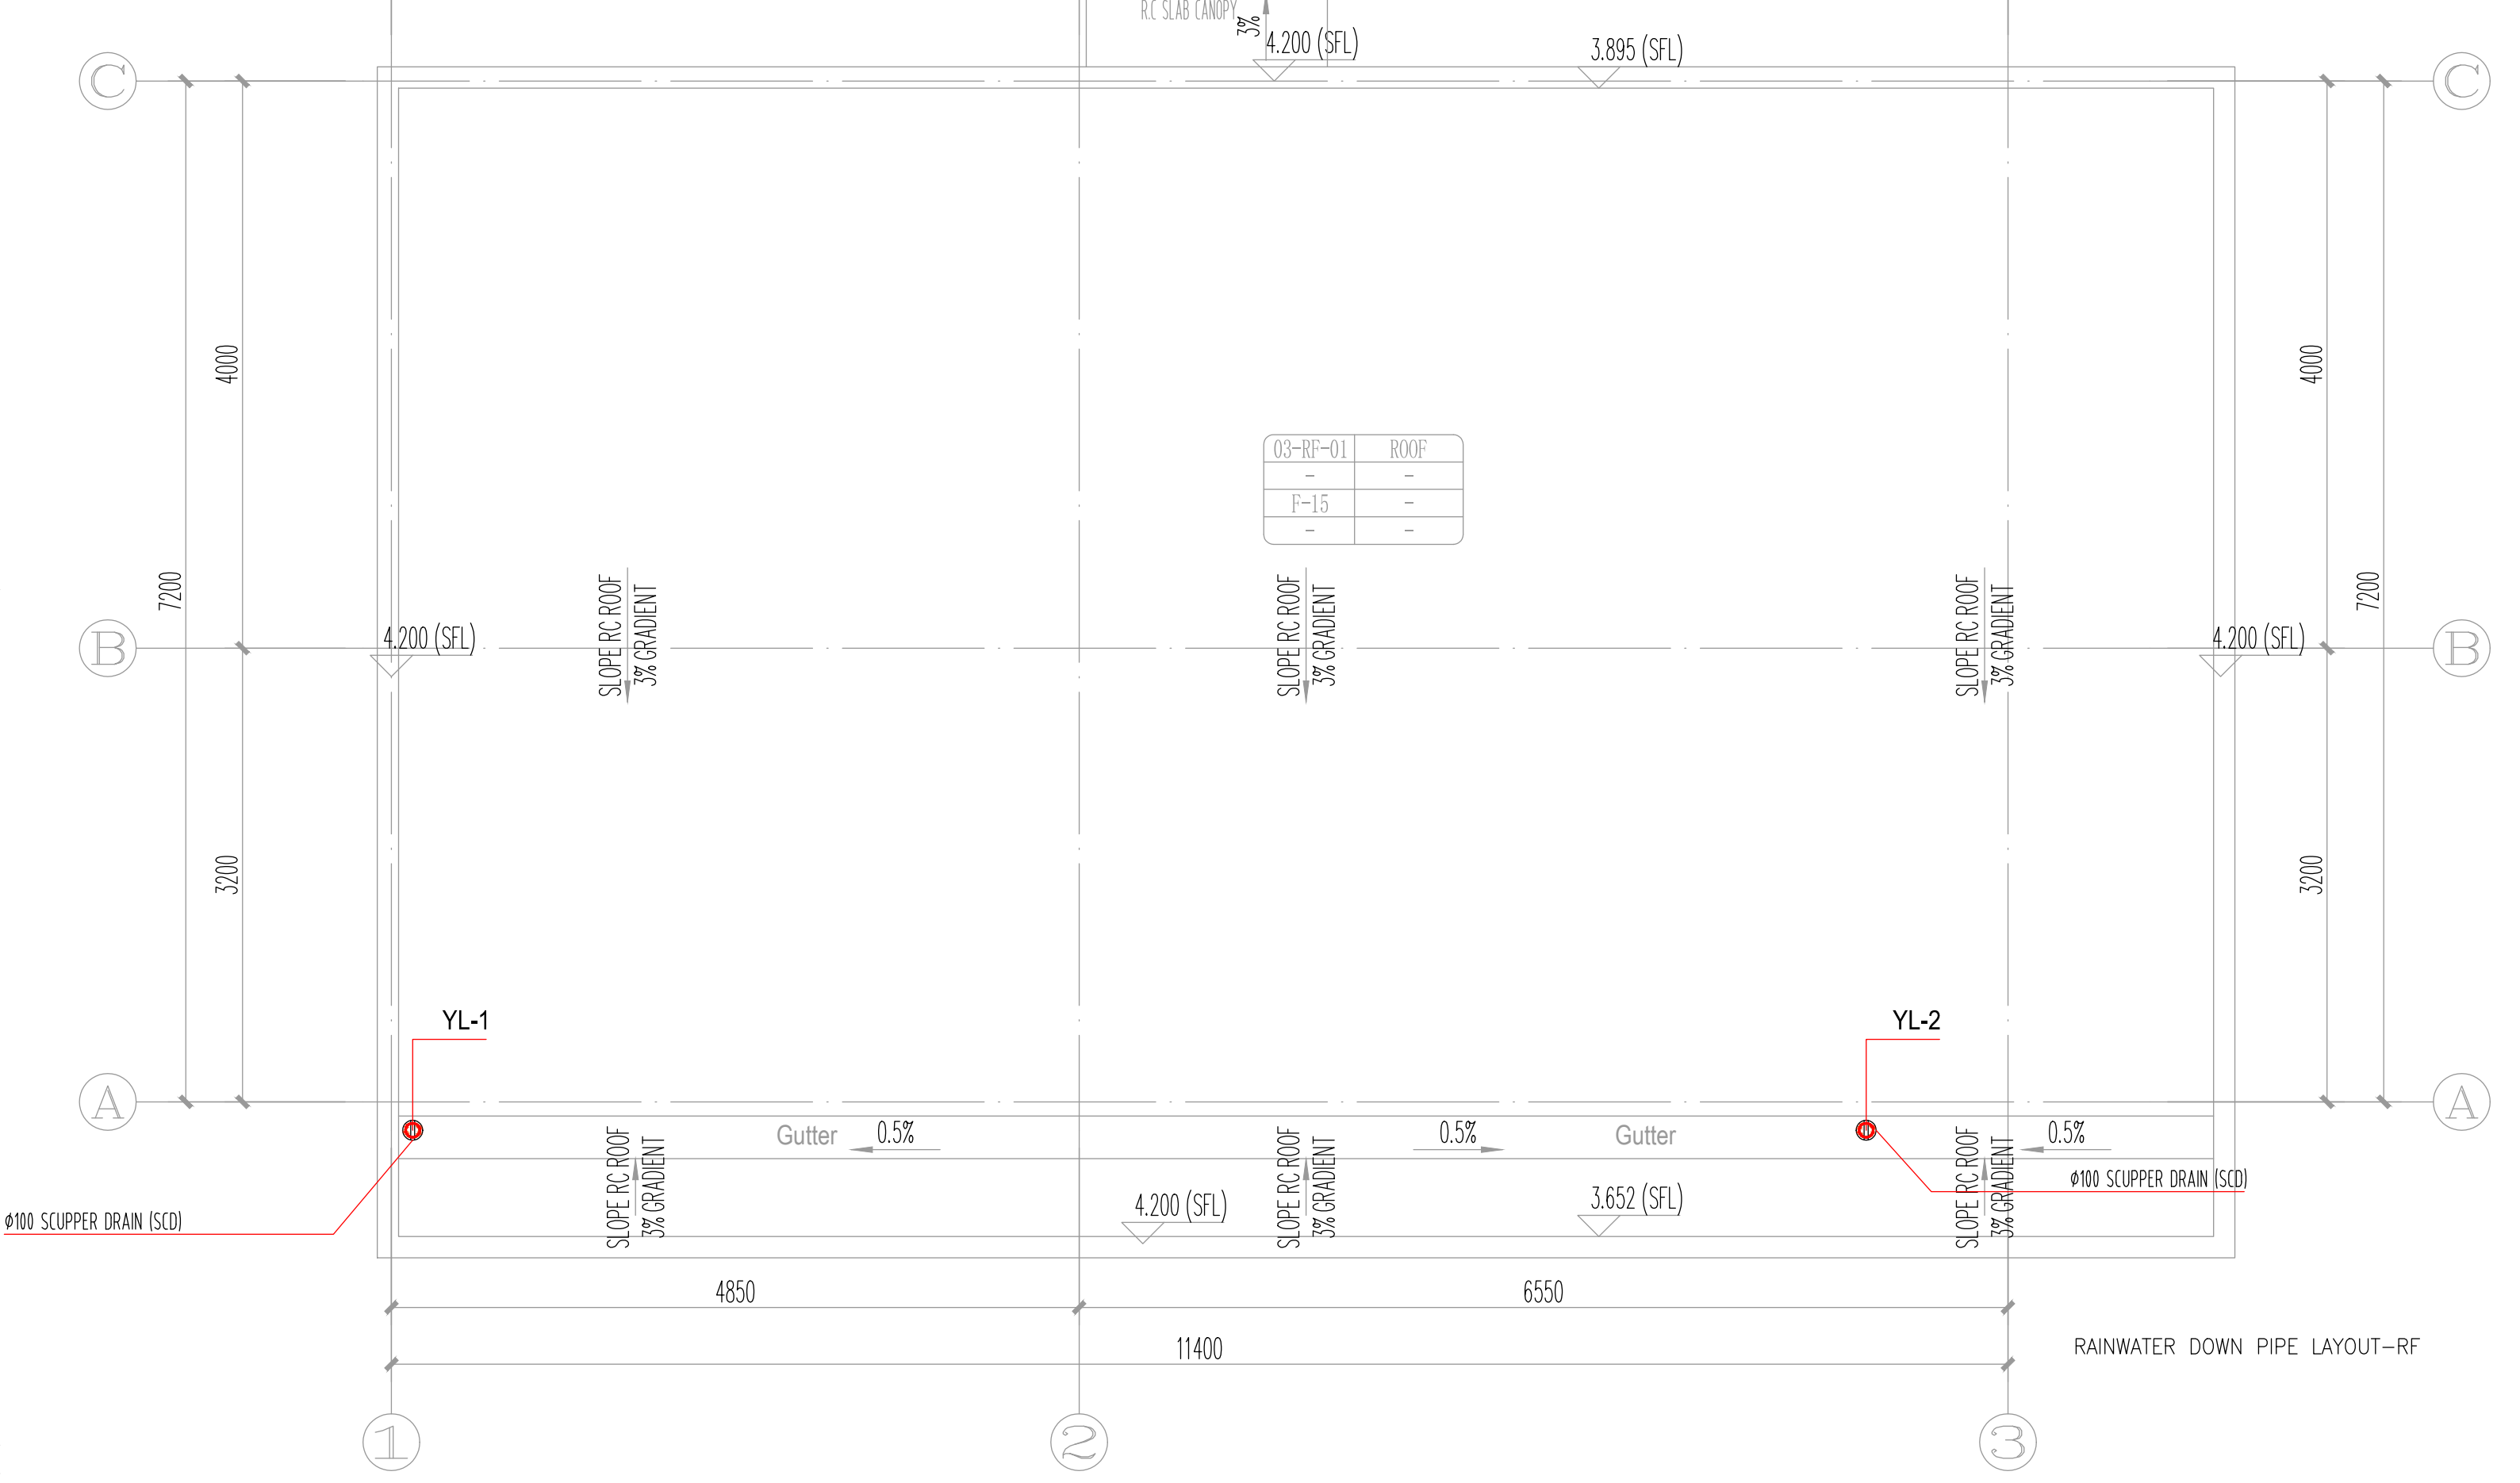

RAINWATER DOWN PIPE LAYOUT-RF

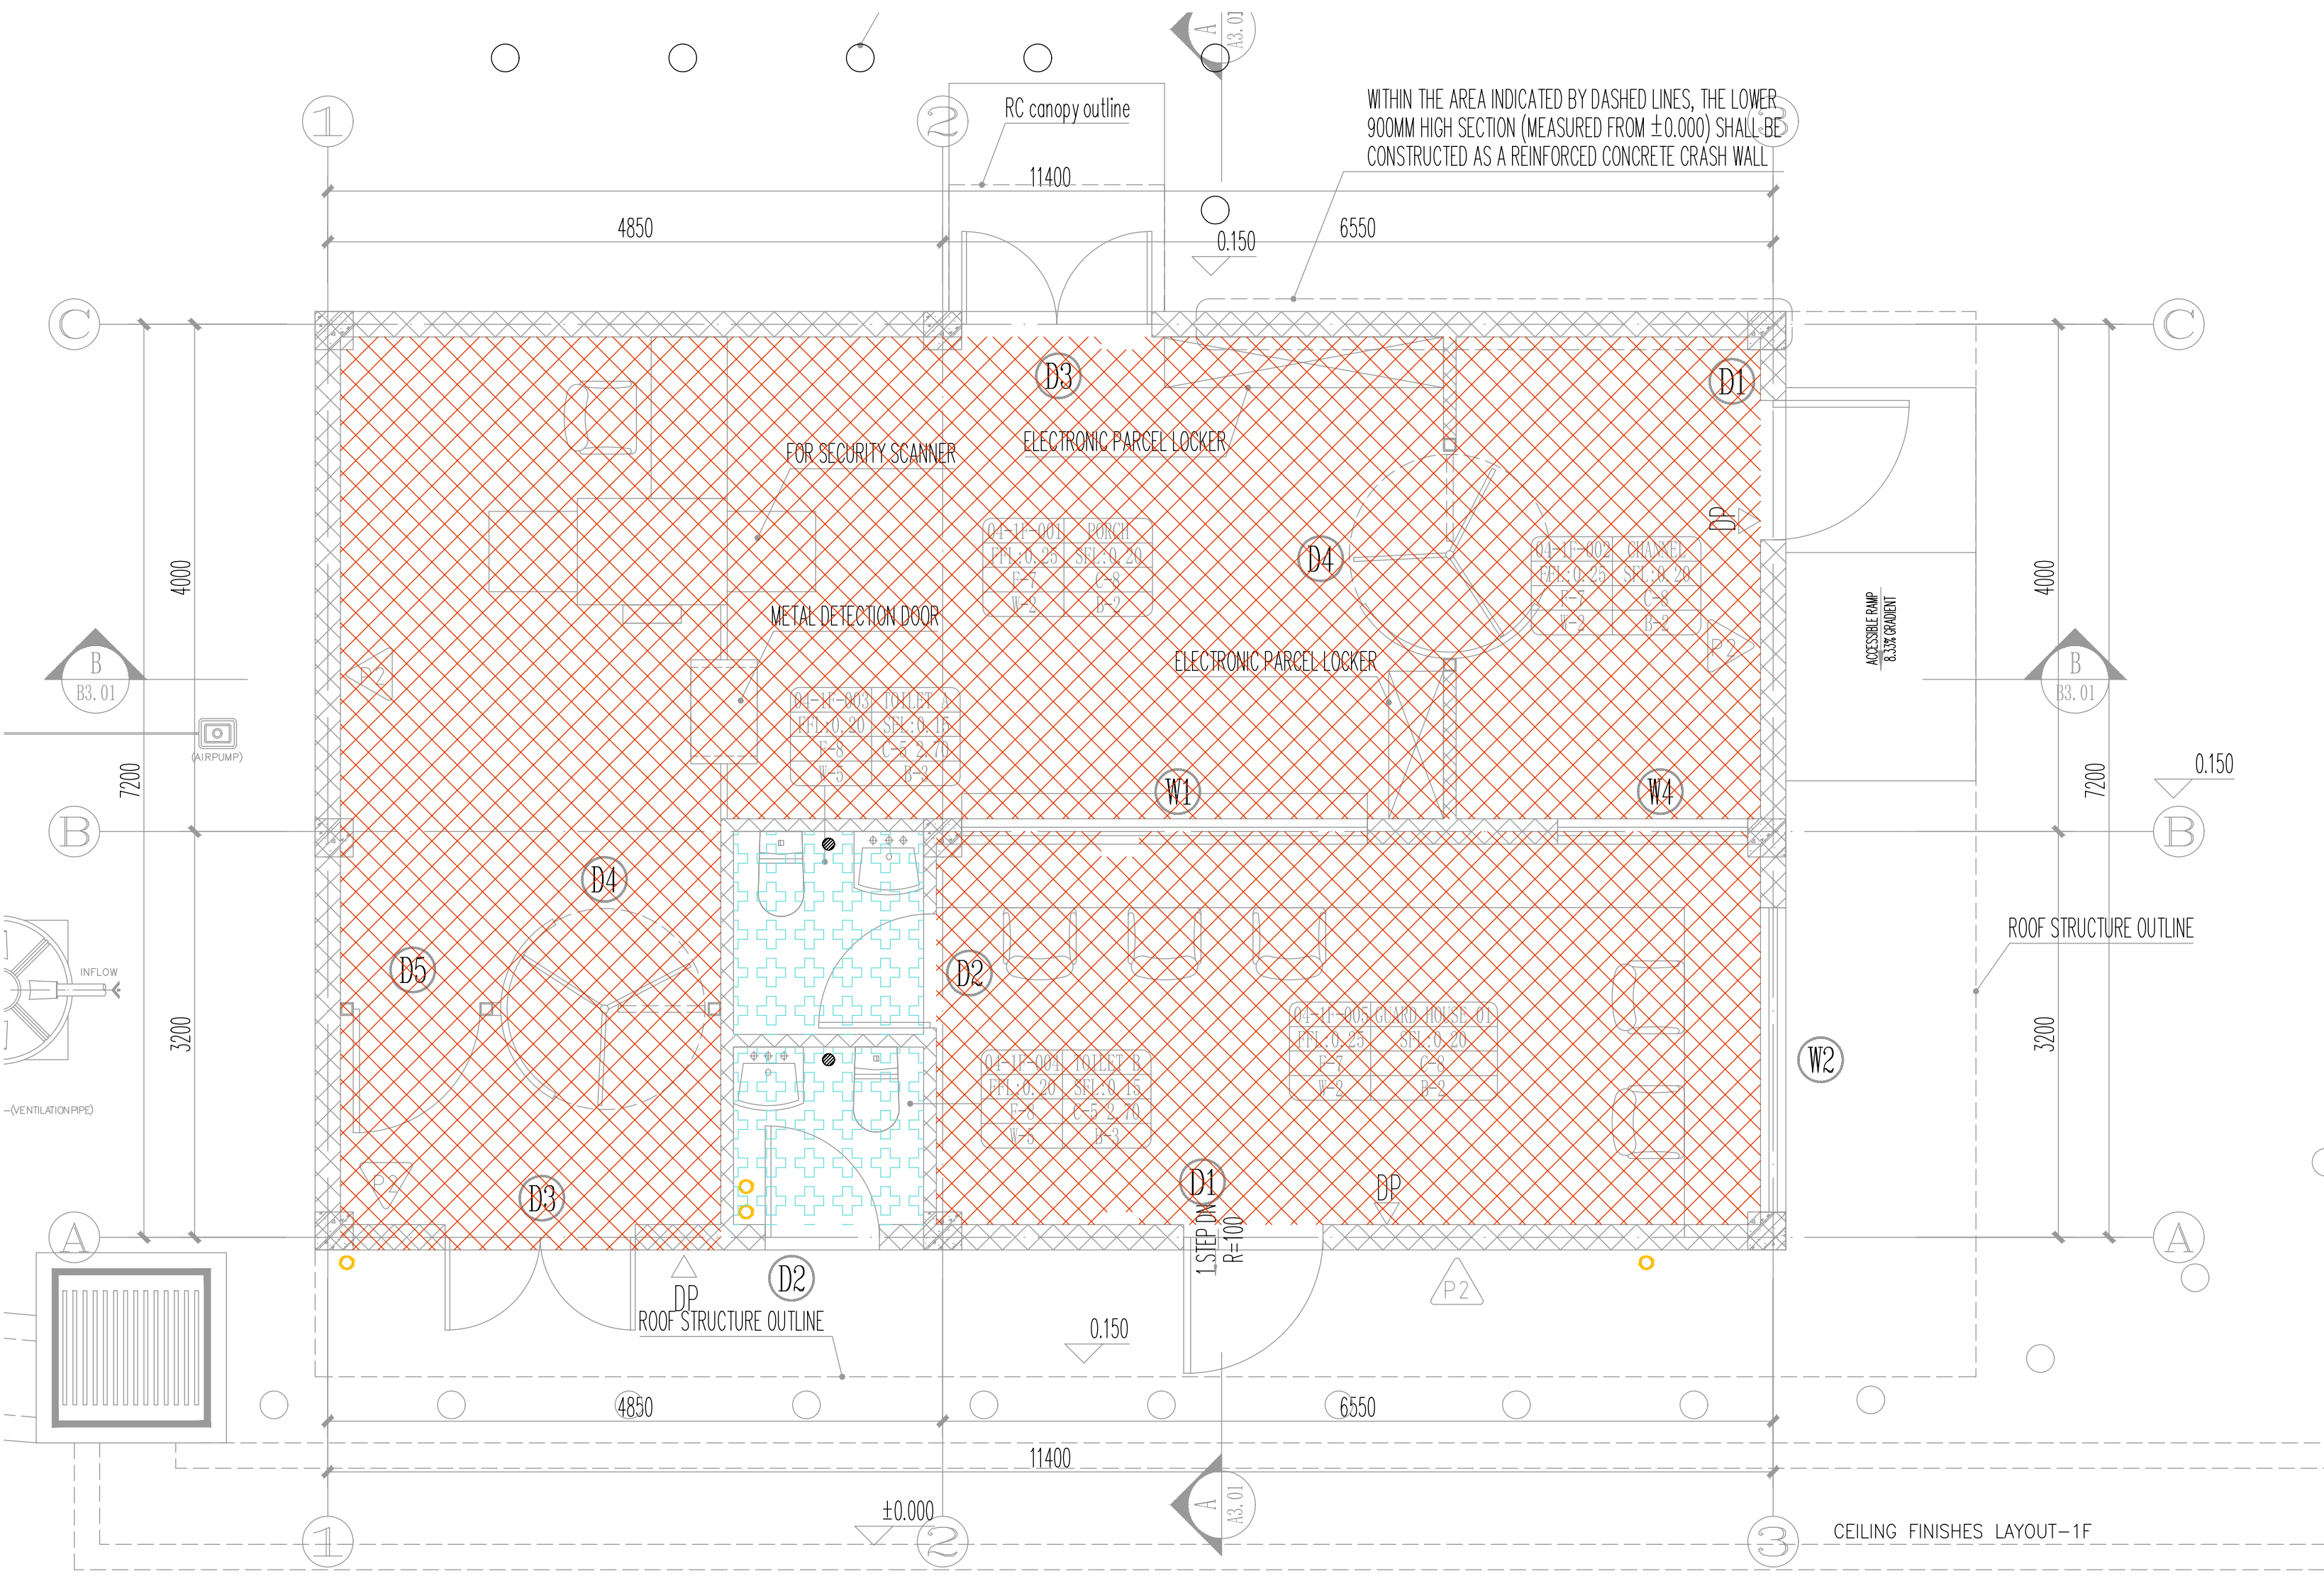
RC canopy outline
11400
4850
6550
0.150
WITHIN THE AREA INDICATED BY DASHED LINES, THE LOWER 900MM HIGH SECTION (MEASURED FROM ±0.000) SHALL BE CONSTRUCTED AS A REINFORCED CONCRETE CRASH WALL
FOR SECURITY SCANNER
ELECTRONIC PARCEL LOCKER
METAL DETECTION DOOR
ROOF STRUCTURE OUTLINE
±0.000

CEILING FINISHES LAYOUT-1F

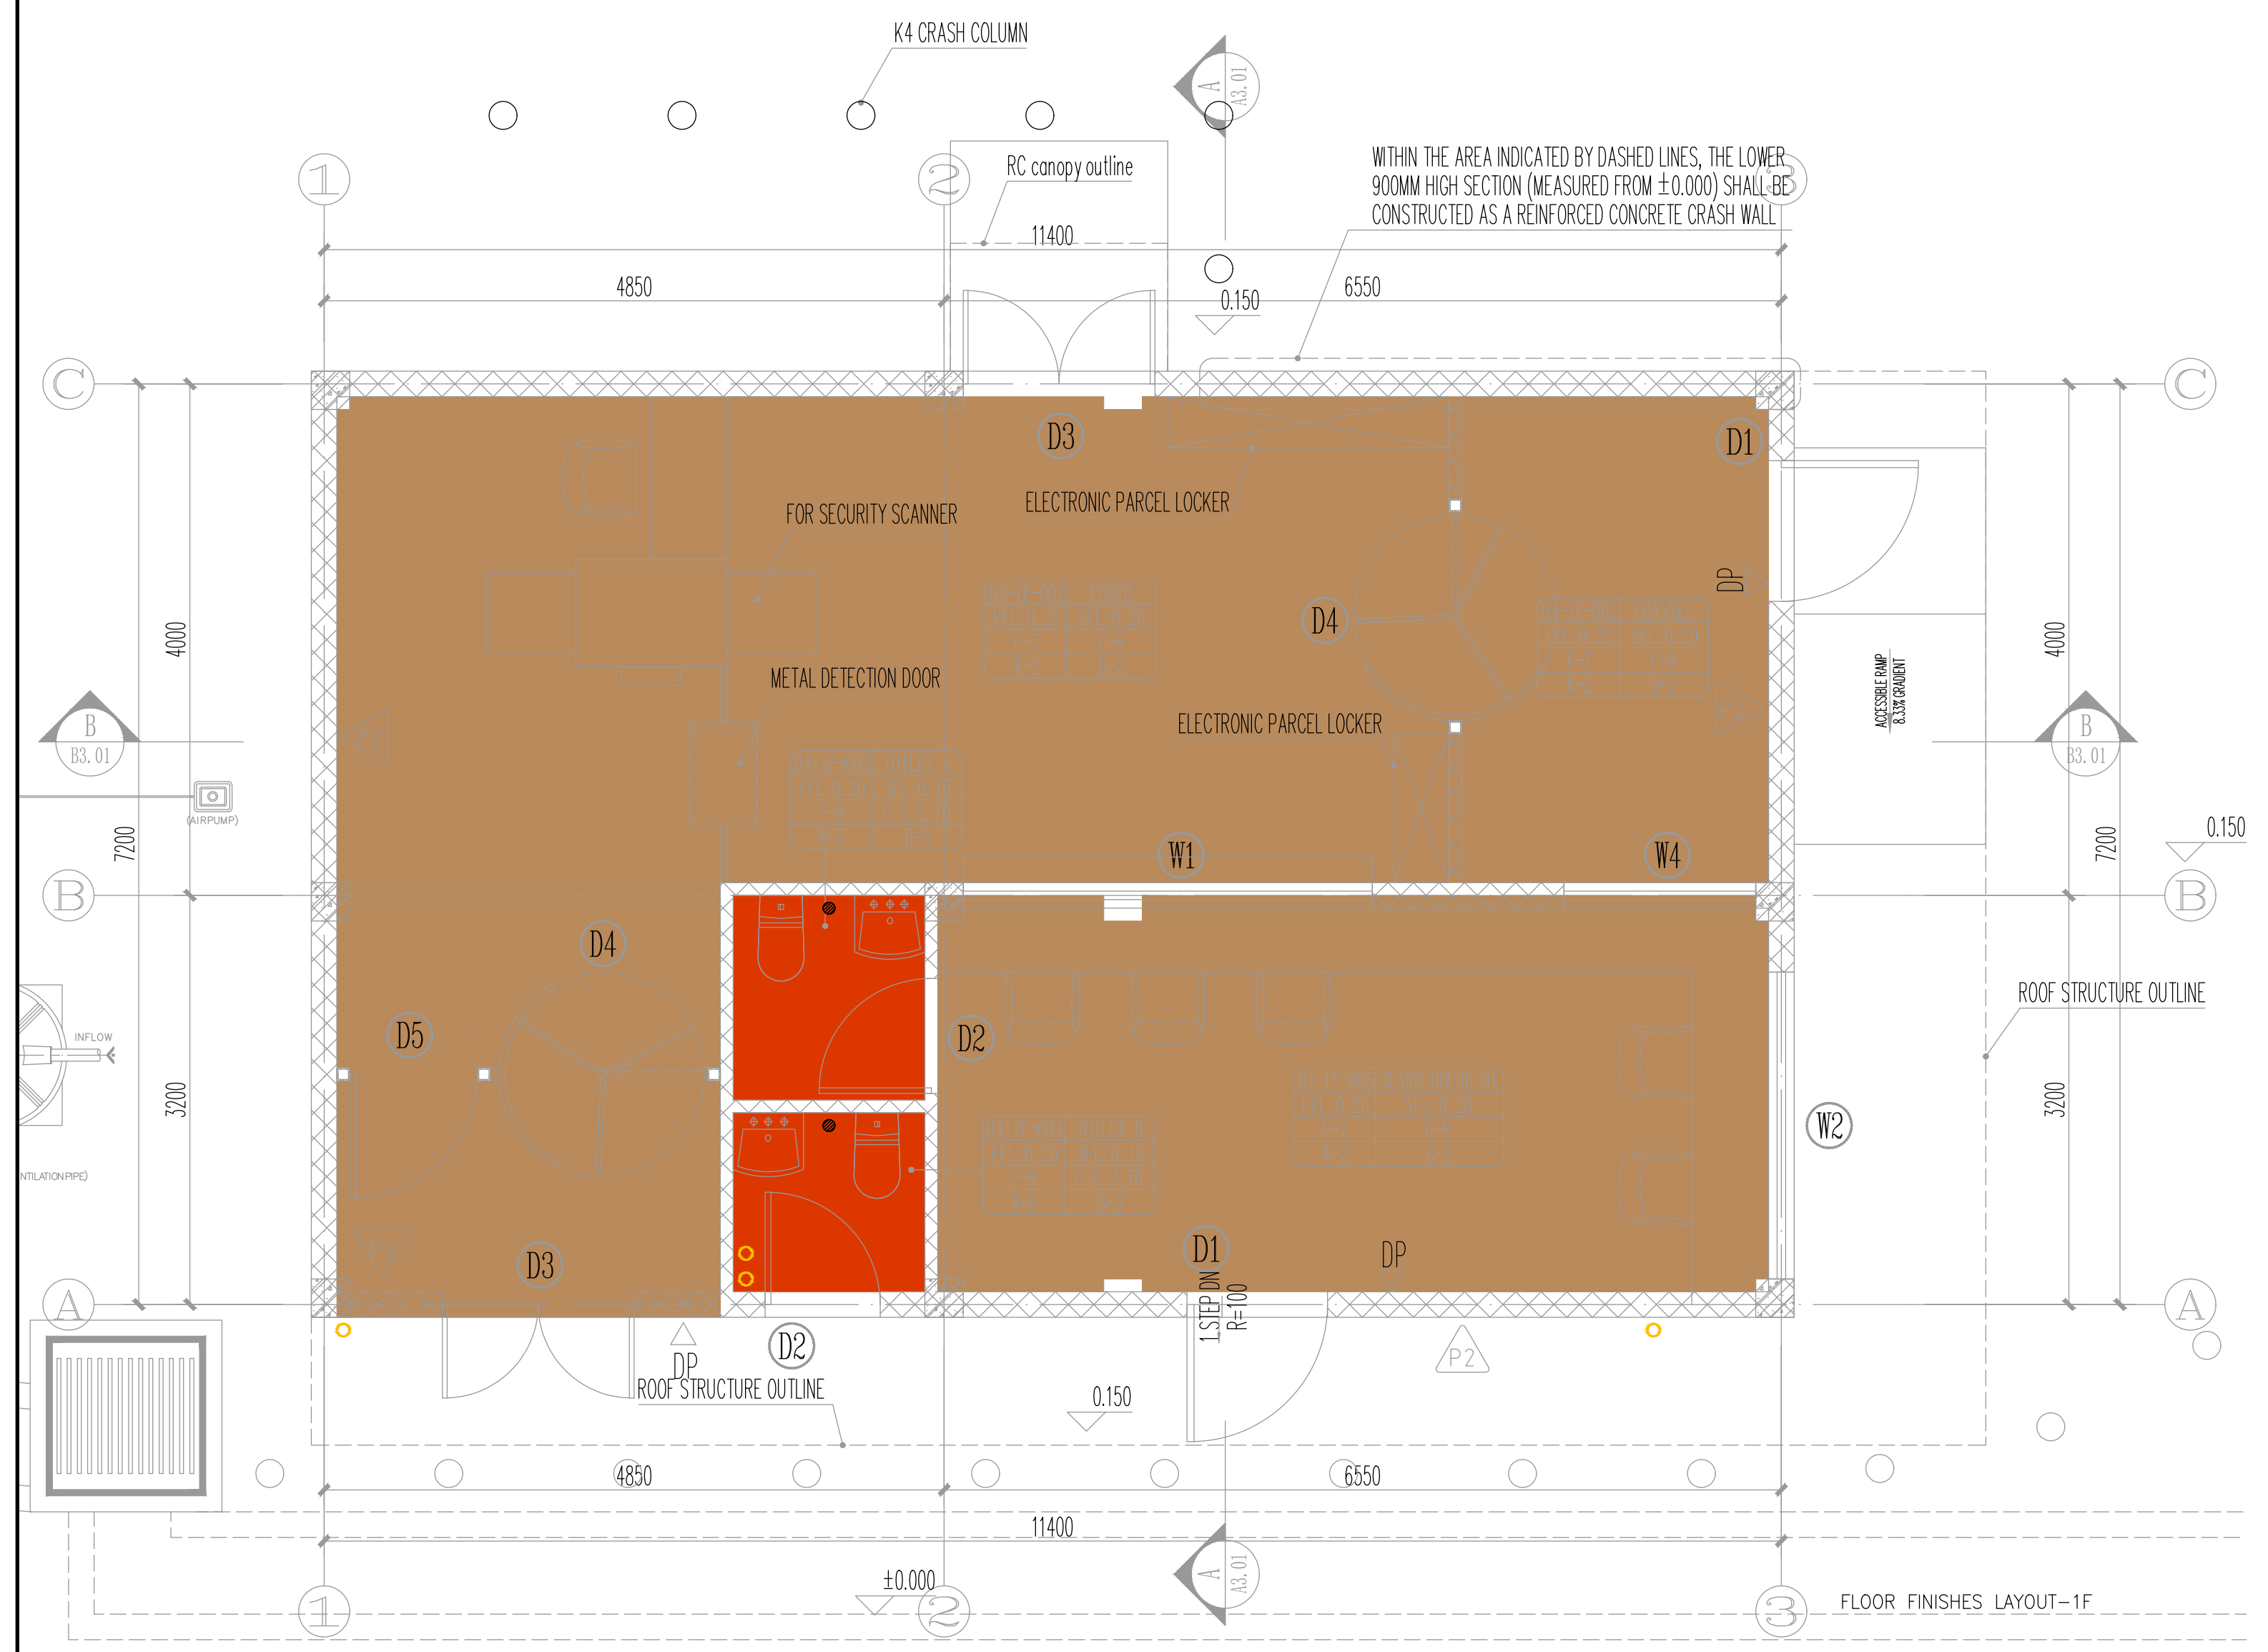
K4 CRASH COLUMN
RC canopy outline
11400
4850
6550
0.150
WITHIN THE AREA INDICATED BY DASHED LINES, THE LOWER 900MM HIGH SECTION (MEASURED FROM ±0.000) SHALL BE CONSTRUCTED AS A REINFORCED CONCRETE CRASH WALL
FOR SECURITY SCANNER
ELECTRONIC PARCEL LOCKER
METAL DETECTION DOOR
ROOF STRUCTURE OUTLINE
±0.000

FLOOR FINISHES LAYOUT-1F

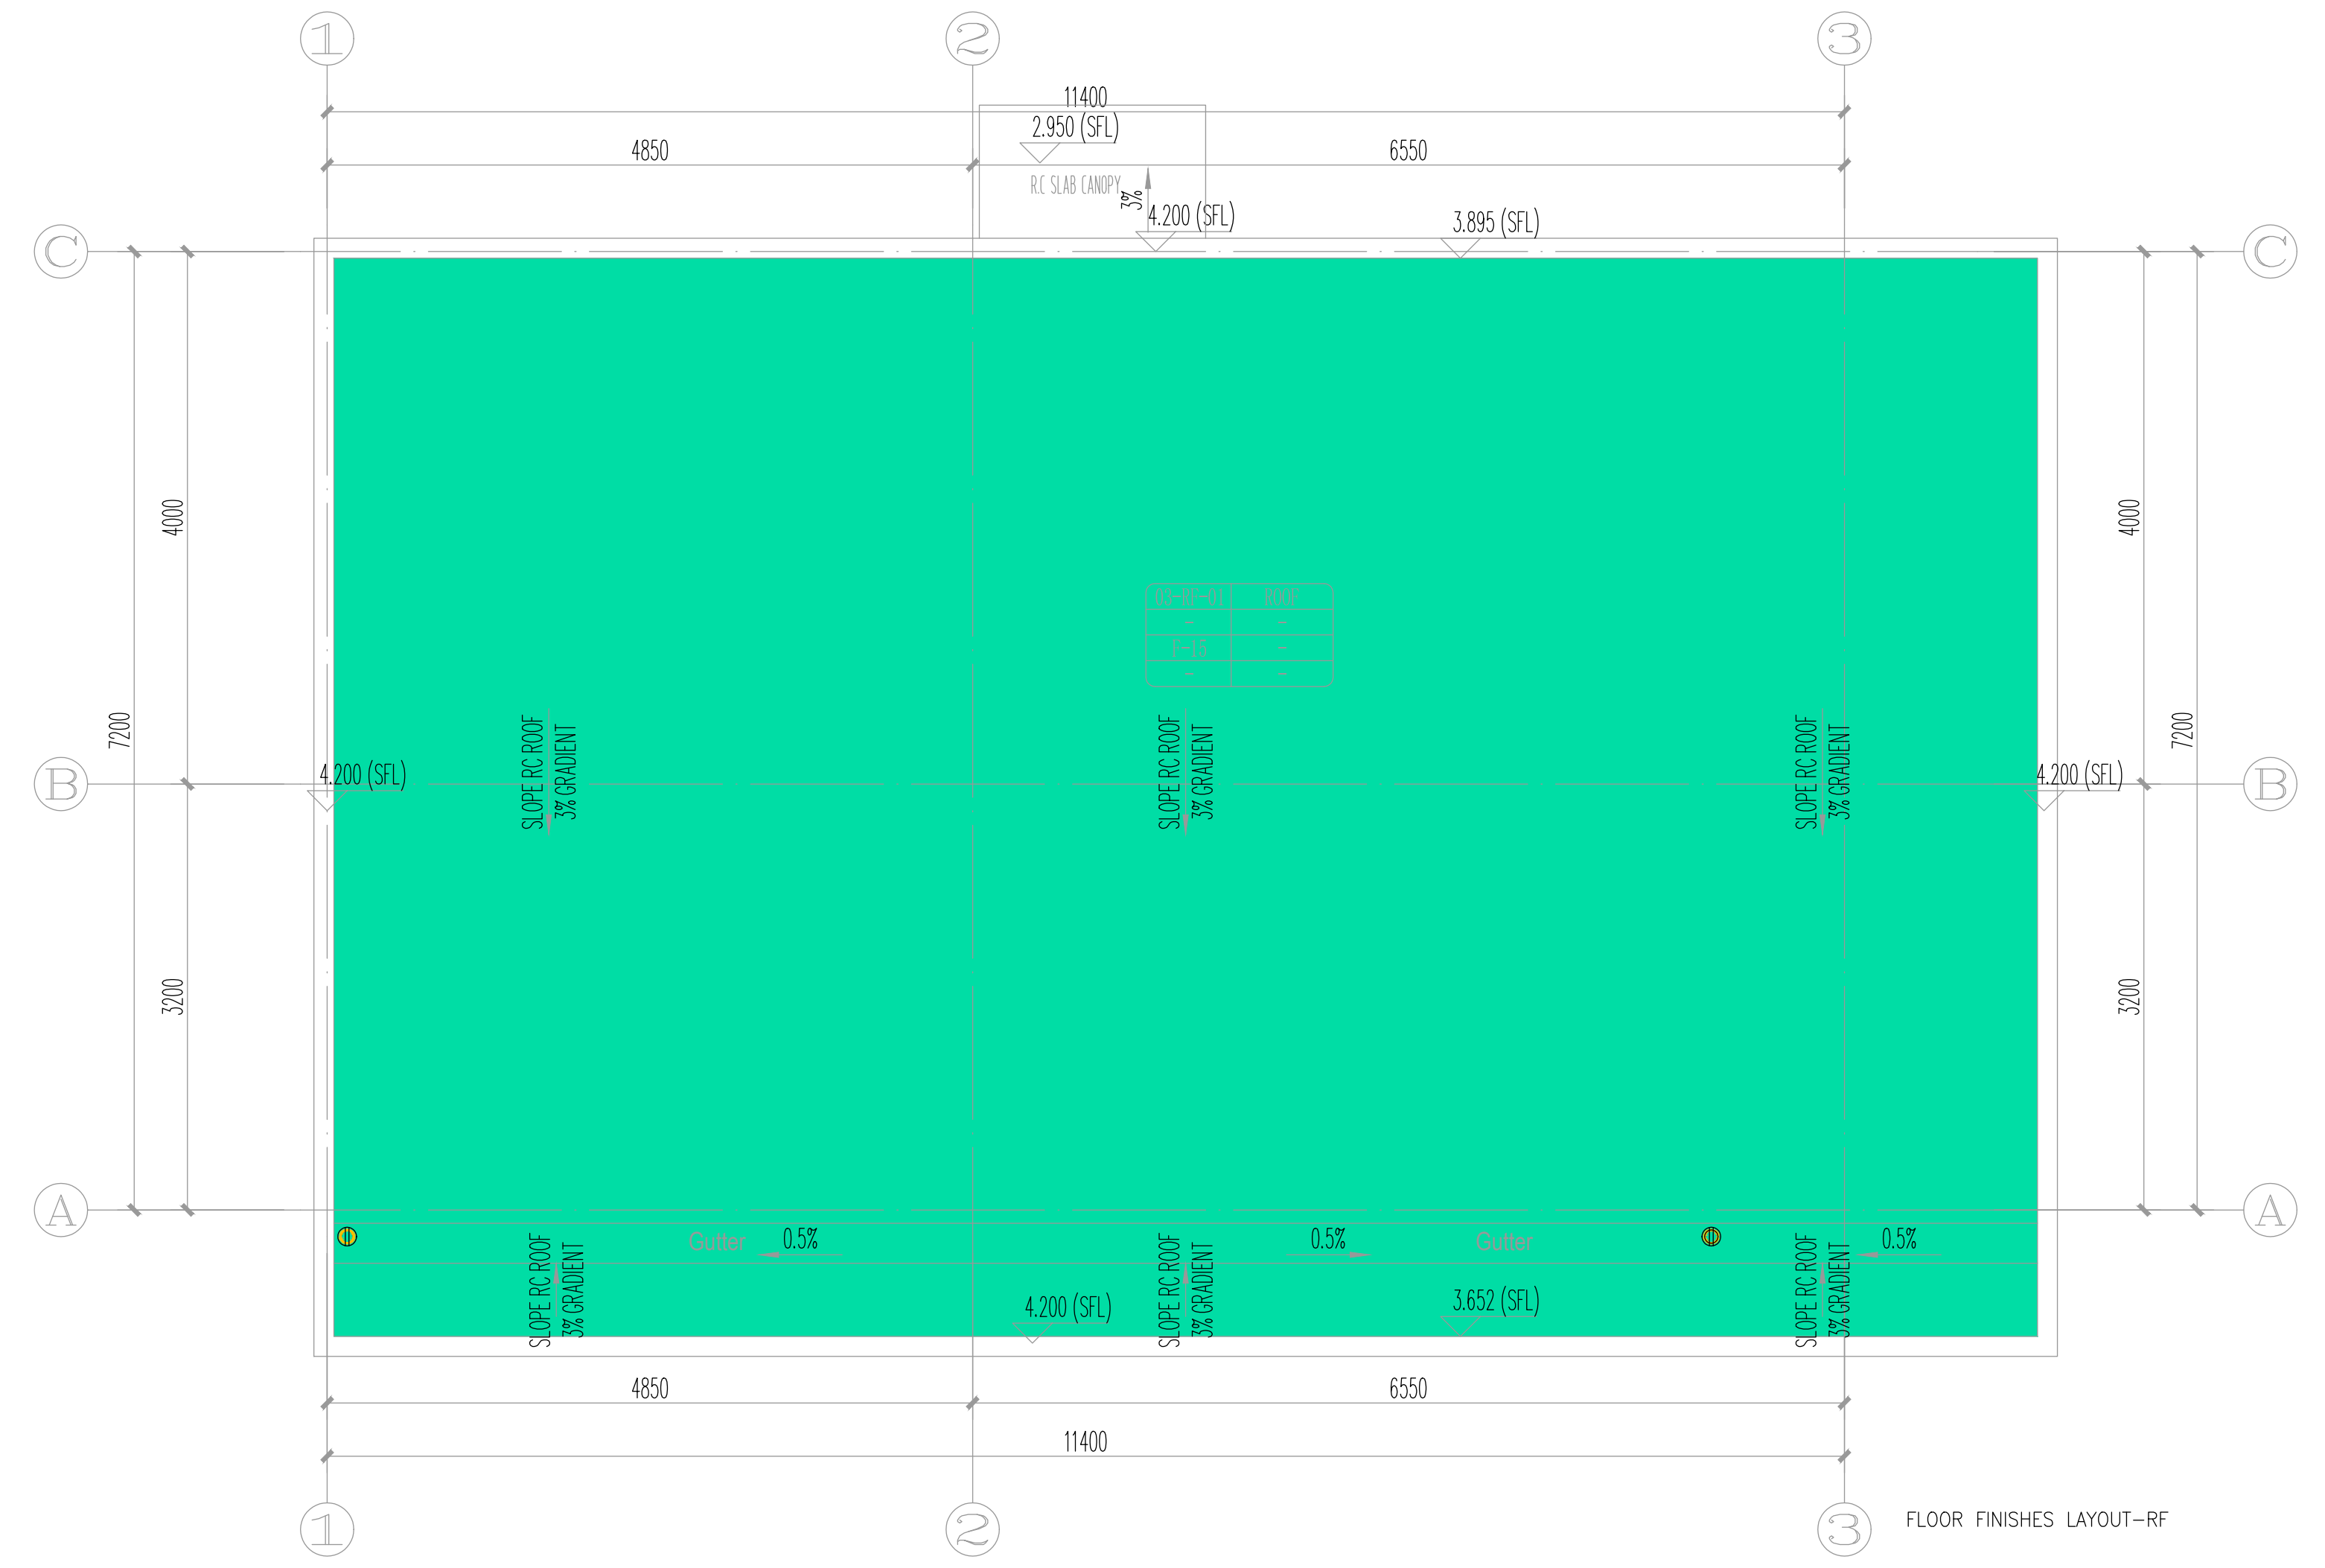

FLOOR FINISHES LAYOUT-RF

Legend	Floor No.	Description	Floor Finish Specification	Vender
🟫	F-7	Ceramic Tile	600x600 Ceramic Tile On Concrete Steel Trowel Finish; Low Voc Content & Emission Adhesive	
🟥	F-8	Porcelain Tile	600x600 12mm Thk Non-slip Homogenous Tile (r10) On Waterproofing,Low Voc Tile Adhesive And Grout	
🟩	F-15	Concrete Roof+ Waterproofing	Concrete Roof + Curing Agent+ Waterproofing	

NOTE : THIS PRINT IS OF A CONFIDENTIAL NATURE, IT SHALL NOT BE TRACED,PHOTOGRAPHED,PHOTOSTATED OR REPRODUCED IN ANY MANER,NOR USED FOR ANY PURPOSE WHATSOEVER EXCEPT BY WRITTEN PERMISSION

CLIENT :

GULF EDGE DC 01

87 Wireless Road, M Thai Tower 11th. Floor, All Seasons Place, Lumpini,
Pathumwan, Bangkok 10330, Thailand

CONTRACTOR :

华西发展(泰国)有限公司
บริษัท หัวซือ ดีเวลลอปเม้นต์ (ประเทศไทย) จำกัด
HUASHI DEVELOPMENT CO.,LTD
No. 202, Room No. 1403, 14/F, Le Concorde Building,
Ratchadapisek Road, Huaykhwang Sub-District,
Huaykhwang District, Bangkok Metropolitan 10310.

CONSULTANT :

ARbay
บริษัท เอ อาร์ เบย์ จำกัด
ARbay Company Limited
31 st Floor Bangkok Insurance Building
25 South Sathorn road Thungmahamek
Sathorn Bangkok 10120 THAILAND
T +66 (0) 2286 8199
F +66 (0) 2286 2863
info@arbay.co.th

CONSULTANT :

Qbic Engineers & Architects Co.,Ltd.
8 Soi KALONG 4 SANAMBINNAM ROAD,
THASAI SUB-DISTRICT, MUANG NONTHABURI DISTRICT
, NONTHABURI.
Tel 662-950-4374
Fax 662-580-3231
E-Mail : qbic@qbic.co.th, www.qbic.co.th
QBIC ENGINEERS AND ARCHITECTS CO.,LTD.

CONSULTANT :

MITR
MITR TECHNICAL CONSULTANT CO.,LTD.
1168/8 12th FLOOR, LUMPINI TOWER BUILDING,
RAMA IV RD., THUNGMAHAMEK, SATHORN, BANGKOK 10120, THAILAND
TEL : 0-2679-9079-84
FAX : 0-2679-9085 E-mail: mitr_dd@mitr.com

Architect : SIGNATURE
ประกิต พนานุรัตน์ วสถ. 580
ที่อยู่
251/1 ถ.จารุเมือง แขวงรองเมือง เขตปทุมวัน
กรุงเทพมหานคร โทรศัพท์ 02-286-8199

Structural Engineer : SIGNATURE
วิศวกรผู้ออกแบบโครงสร้าง
ณัฐสม สงวนวงษ์ วย 1423
ที่อยู่
2/1 ซ.รามคำแหง 150 ถ.รามคำแหง
แขวง สะพานสูง เขต สะพานสูง กทม. 10240

Structural Inspector : SIGNATURE
วิศวกรผู้ตรวจสอบโครงสร้าง
โกมล จุฑาภัทร วย 964
ที่อยู่
24/18 ซ.นวมินทร์ 129 ถ. นวมินทร์
แขวง นวลจันทร์ เขต บึงกุ่ม กทม. 10230

Electrical Engineer : SIGNATURE
วิศวกรผู้ออกแบบระบบไฟฟ้ากำลัง
นายสุภัทร บูรณวิทย์ วฟก.1265
ที่อยู่
21 ซอยทานสัมฤทธิ์ 13
ตำบลท่าทราย อ.เมืองนนทบุรี จ.นนทบุรี 11000

Mechanical Engineer : SIGNATURE
วิศวกรผู้ออกแบบระบบเครื่องกลและปรับอากาศ
นายประสิทธิ์ เกียวสุนทร วก.1221
ที่อยู่
44/372 ซอยบางกระดี่ 35/1 แขวงแสมดำ
เขตบางขุนเทียน กทม. 10150
ประสิทธิ์

Sanitary Engineer : SIGNATURE
วิศวกรผู้ออกแบบระบบสุขาภิบาล และดับเพลิง
นายทศวรรษ สนันฤทธิ์ วส. 215
ที่อยู่
บ้านเลขที่ 99/107 หมู่ที่ 3 ต.ศีรษะจรเข้น้อย
อ.บางเสาธง จ.สมุทรปราการ 10540
ทศวรรษ

ISSUE/REVISION

REV.	DESCRIPTION	DATE
A	90% DEVELOPED	09/05/2026

PROJECT NAME :
GEDC 01

LOCATION:
Nikhom Phattana district, Rayong ,industrial estate,CPGC

BUILDING :
GUARD HOUSE A

90% DEVELOPED

TITLE :
FLOOR & CEILING FINISHES & WATERPROOFING & RAINWATER DOWN PIPE LAYOUT

JOB NO.	SCALE 1:50
DRAWN LK	REF.
CHECKED LJC	DWG.NO. MPK04-60-A-FF&CL&WP&RWDP-101
APPROVED LXD	
DATE 2026.05.09	